


T.8S., R.39E., W.M.

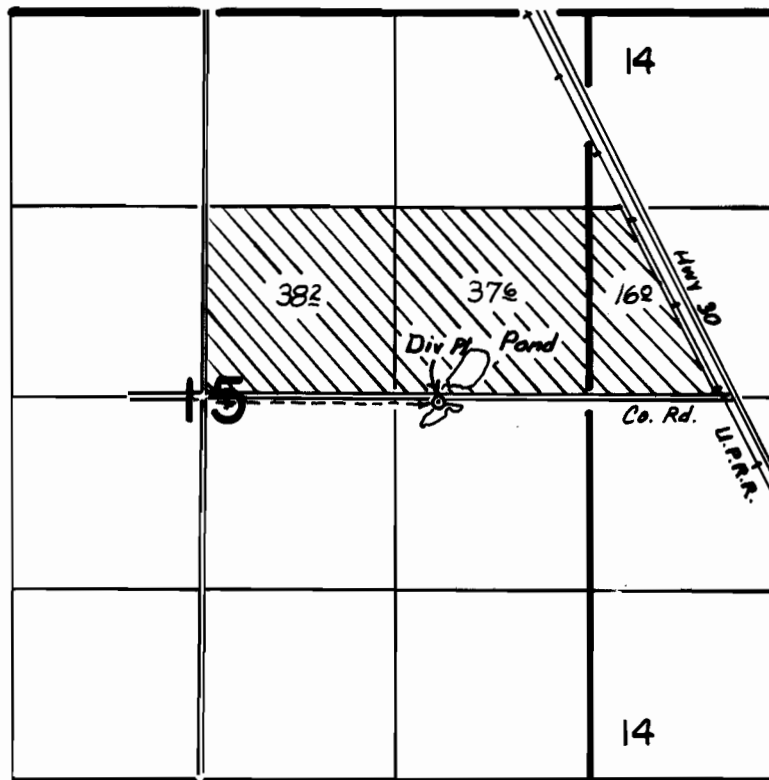

The location of the div. pt. is 40'S. & 1030' W.
from E $\frac{1}{4}$ cor. sec. 15.

FINAL PROOF SURVEY
UNDER


Scale: 1" = 1320'

Application No. 64325 Permit No. 47419.....
IN NAME OF

CLIFFORD W. & PHYLLIS A. JONES

Surveyed 10-8..... 1987, by Vern. Church.....

41001-279-71L KK