


T. 22 S., R. 4 W., W.M.

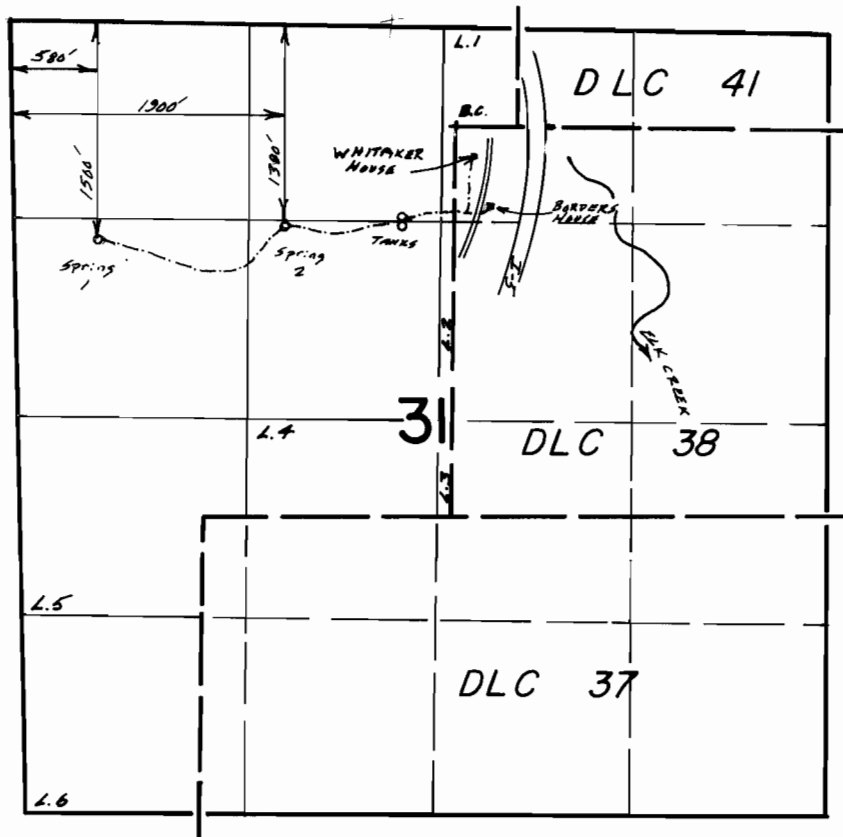

Scale 1" = 1320'

FINAL PROOF SURVEY
UNDER

Application No. 64833 Permit No. 47368...
IN NAME OF

MARY ELLEN WHITAKER & LOUIS D. & LILLIAN BORDERS

Surveyed Aug. 22, 1991, by S. James...
Oct. 10, 1991