


P-4757
C-60818

T. 15 S., R. 31 & 32 E., W.M.

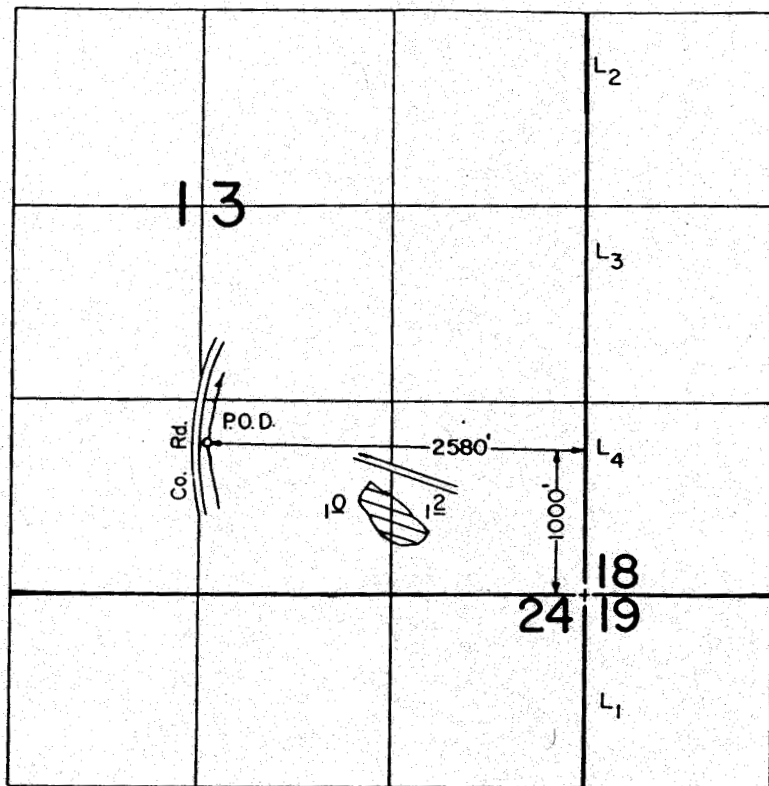

Scale : 1" = 1320'

FINAL PROOF SURVEY
UNDER

Application No. 65095 Permit No. 47572
IN NAME OF

CLIFF BELCHER, JR.

Surveyed JUNE 21 1988, by T. Warren