


T. 1N., R. 38E., W.M.

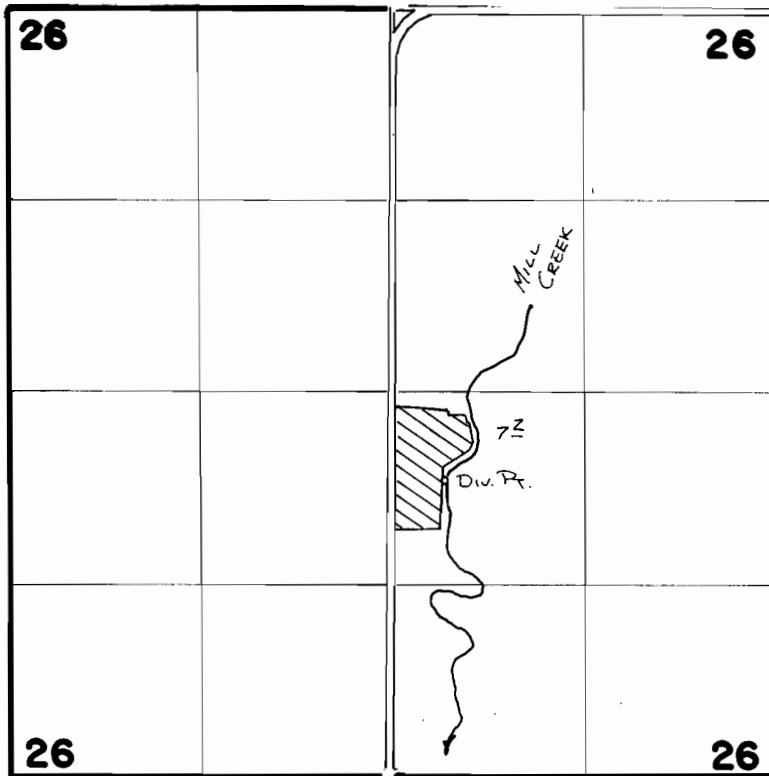

Div. Pt. Loc: 2030'N & 2280'W FROM SE CORNER
 SEC. 26.

SCALE 1"=1320'

FINAL PROOF SURVEY
 UNDER

Application No. **65975** Permit No. **48073**
 IN NAME OF

HOWARD H. BUTTS

Surveyed 19....., by