
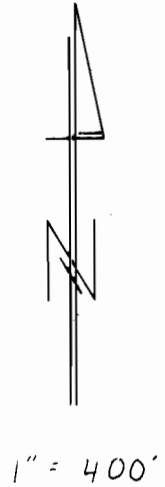


# T8N, R8W, WM SEC 17 & 20

← COLUMBIA RIVER

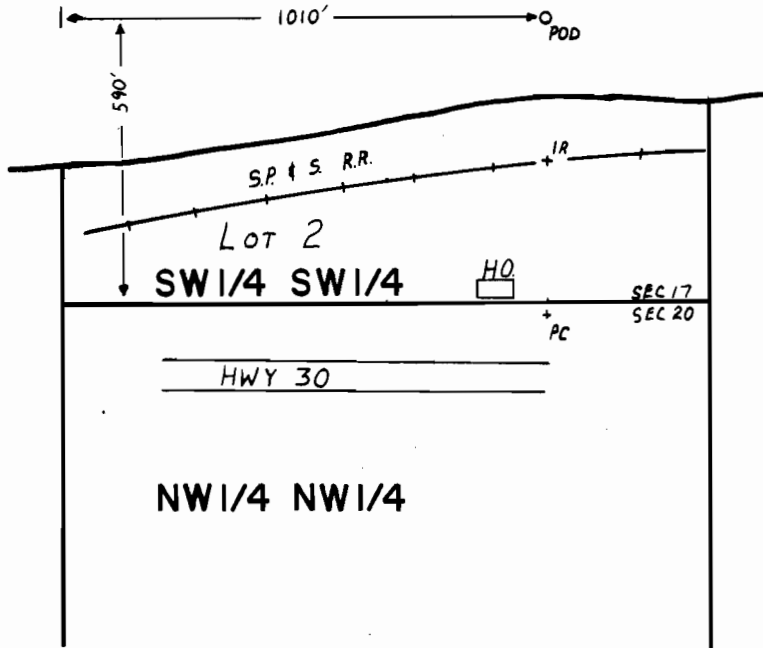

## FINAL PROOF SURVEY UNDER

Application No. 6.7.5.4.4 Permit No. 4.8.2.5.8.....  
IN NAME OF

.....LEWIS WILSON.....

Surveyed JULY..19.. 1988., by T.M. WARREN.....

RWK  
PTS W/EP