




T. 28 S., R. 11 W., W.M.

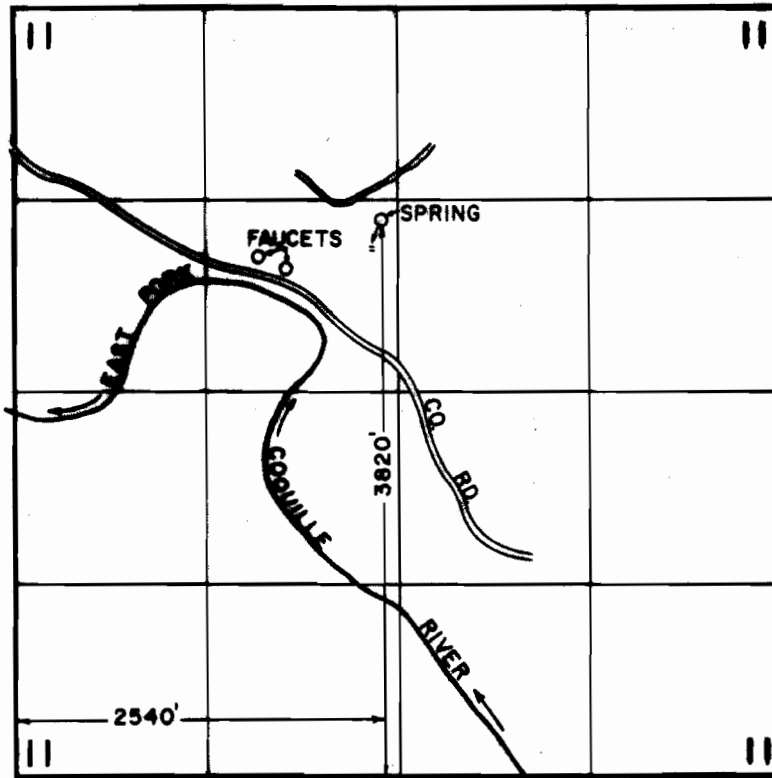

SCALE: 1" = 1320'

FINAL PROOF SURVEY
UNDER

Application No. 67705... Permit No. 48510.....
IN NAME OF

COOS COUNTY PARKS DEPARTMENT

Surveyed SEPT. 18, 1988, by B. S. JAMES.....