


T8N, R8W, WM SEC 17 & 20

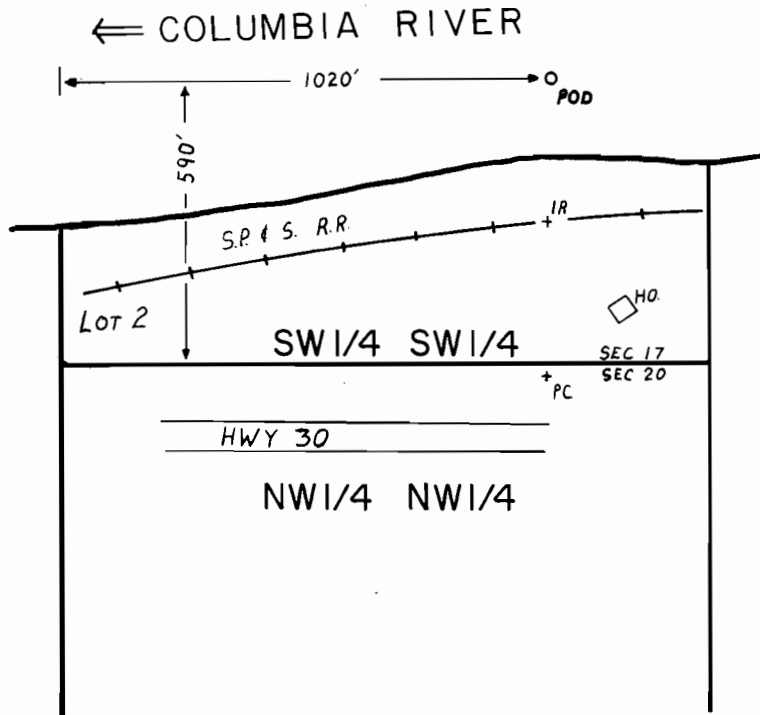

1" = 400'

FINAL PROOF SURVEY UNDER

Application No. 6.7.9.6.4 Permit No. 4.8.2.2.5...
IN NAME OF

.....EDWARD J. ENG.....

Surveyed JULY 19, 1988., by T.M. WARREN...

RWK
PTS W/EE