


T. 3N., R. 3W., W.M.

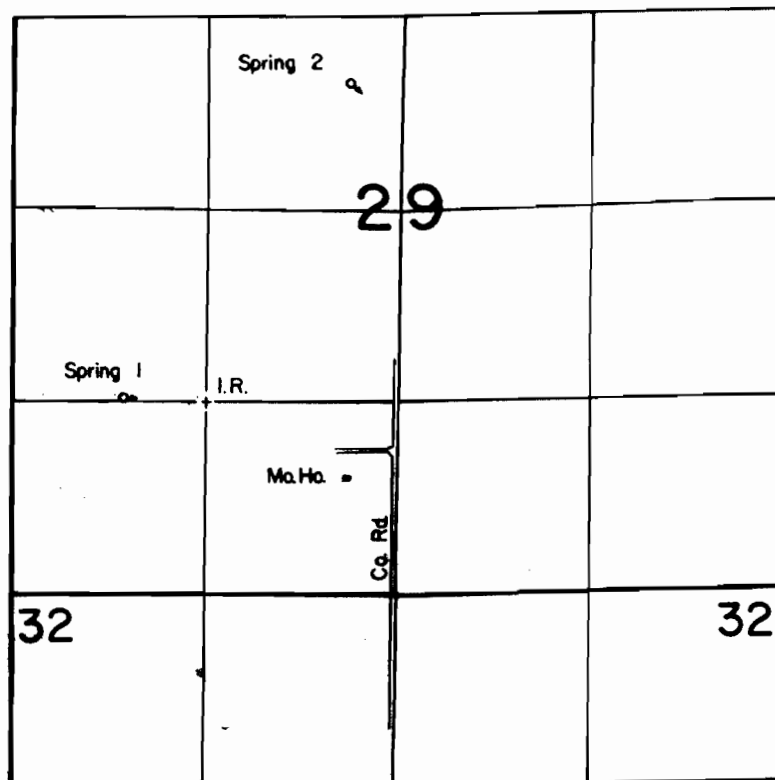

Spring 1 Loc. : 20' N. & 560' W.

Spring 2 Loc. : 2180' & 980' E., both from SE Cor. NW⁴ SW⁴ Sec. 29.

Scale : 1" = 1320'

FINAL PROOF SURVEY
UNDER

Application No. 68003... Permit No. 48460...
IN NAME OF

FORREST E. & ROSEMARY BUMP

Surveyed Sept. 1... 1988, by T. Warren.....

41067-278-207B
11/14/88 T.M.W.