


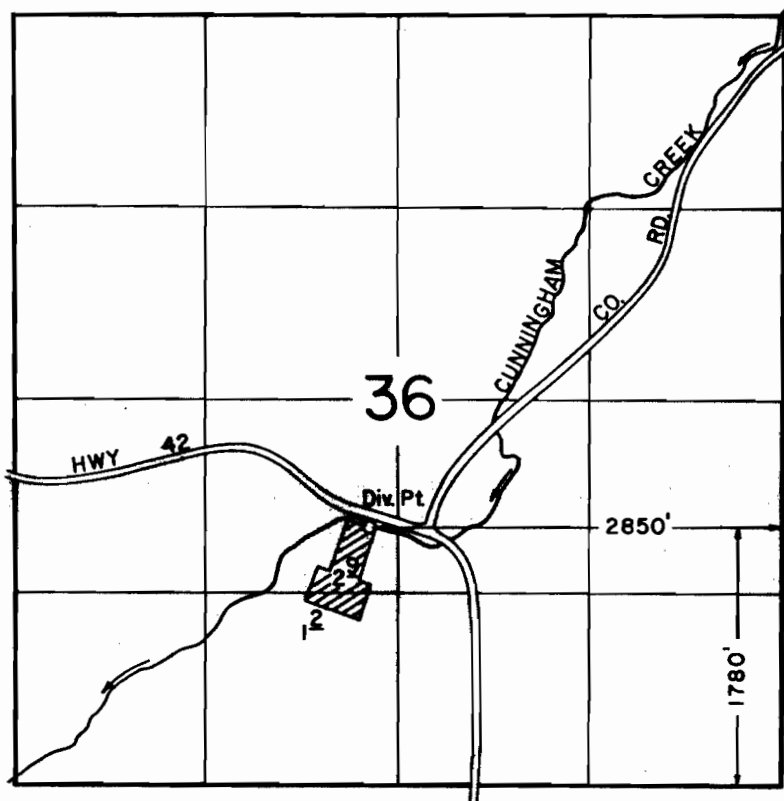

T.27S.,R.13W.,W.M.



SCALE: 1" = 1320'

**FINAL PROOF SURVEY**  
UNDER

Application No. 69148 Permit No. 50080

IN NAME OF

WILLIS G. STUMP

Surveyed SEPT. 19 1988, by K. KEMP