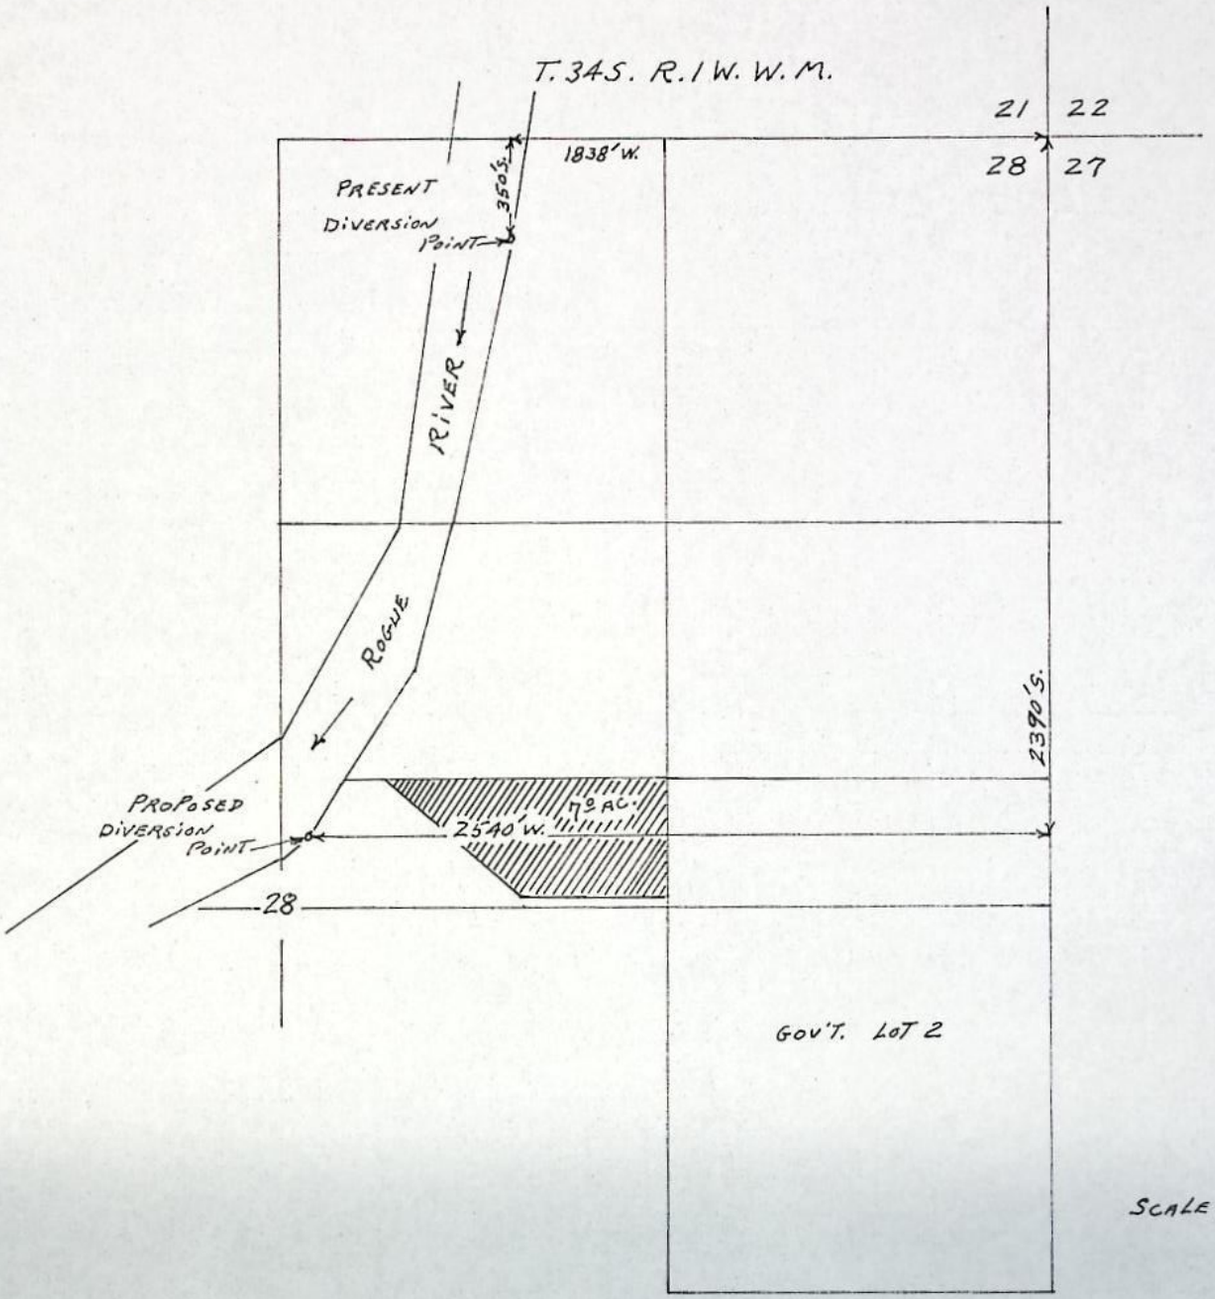


SCALE 8" = 1 MILE

N

MAP TO ACCOMPANY APPLICATION OF
KAY PHILLIP SHUGART FOR CHANGE
IN POINT OF DIVERSION ON CERT. # 10523
PRIORITY NOV. 18 1922


RECEIVED
JUN 11 1976
WATER RESOURCES DEPT
SALEM, OREGON

6-10-76

T-3423

T. 34 S., R. 1W., W.M.

SEC. 28

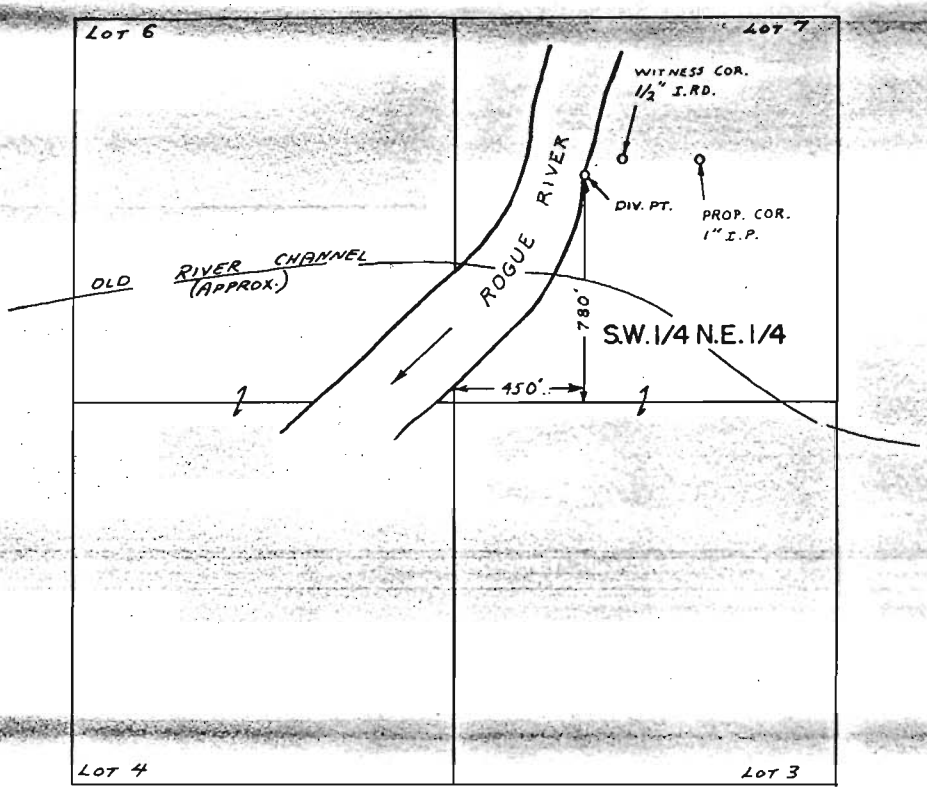

SCALE : 1" = 660 FT.

This cert. CLIPOD approved by order of Director, 10-26-79 and together with Cert. 48962, Vol. 42 and two orders of Director of 10-26-69 supersede Cert. 10523, Vol. 10.

FINAL PROOF SURVEY

UNDER

Transfer ~~No. 3425~~

Transfer No. 3426

Application No. 8726 Permit No. 5695 - Cert. No. 49186

IN NAME OF

TRUMAN DEAN & Z. IDELLE COLLINS

Surveyed AUG. 16 1978, by B. SUND

P.T.S. - 1978 - 14 - C