


T. 34 S., R. 1 W., W. M.

SEC. 28

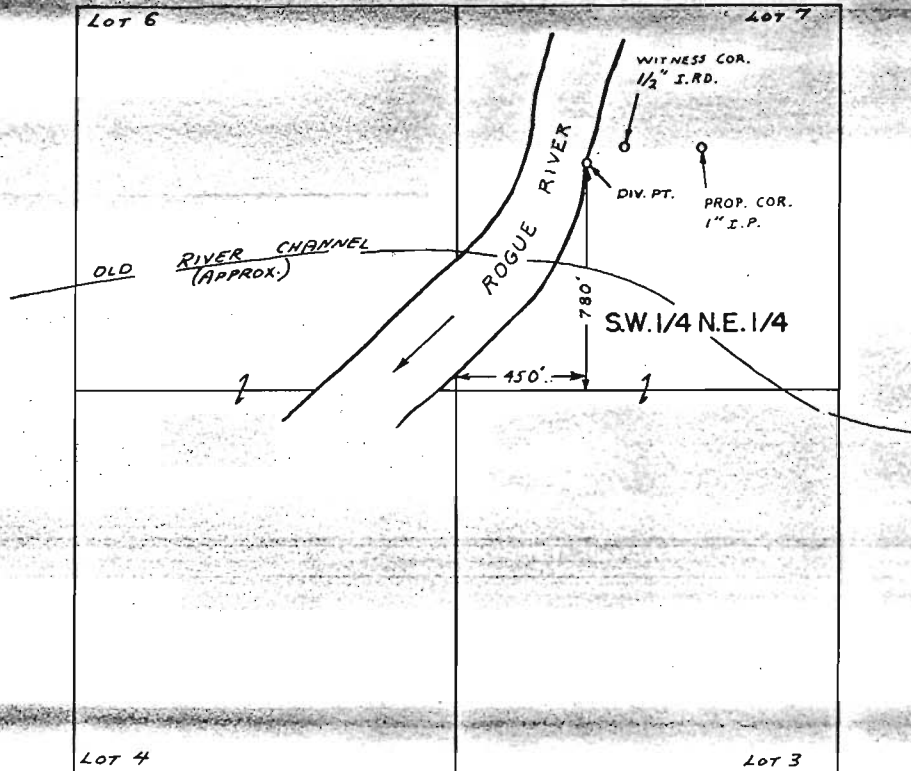

SCALE : 1" = 660 FT.

FINAL PROOF SURVEY UNDER

Transfer No. ~~3425~~

Transfer No. 3426

Application No. 8726 Permit No. 5695 - Cert. No. 49186
IN NAME OF

TRUMAN DEAN & Z. IDELLE COLLINS

Surveyed AUG. 16 1978 by B. SUND

*This cert. C170D
approved by order of
Director 10-26-79
and together with
Cert. 48962, Vol. 42
and two orders of
Director of 10-26-69
supersede Cert. 10523, Vol. 10.*