


T.27 S.R.11 W.W.M.

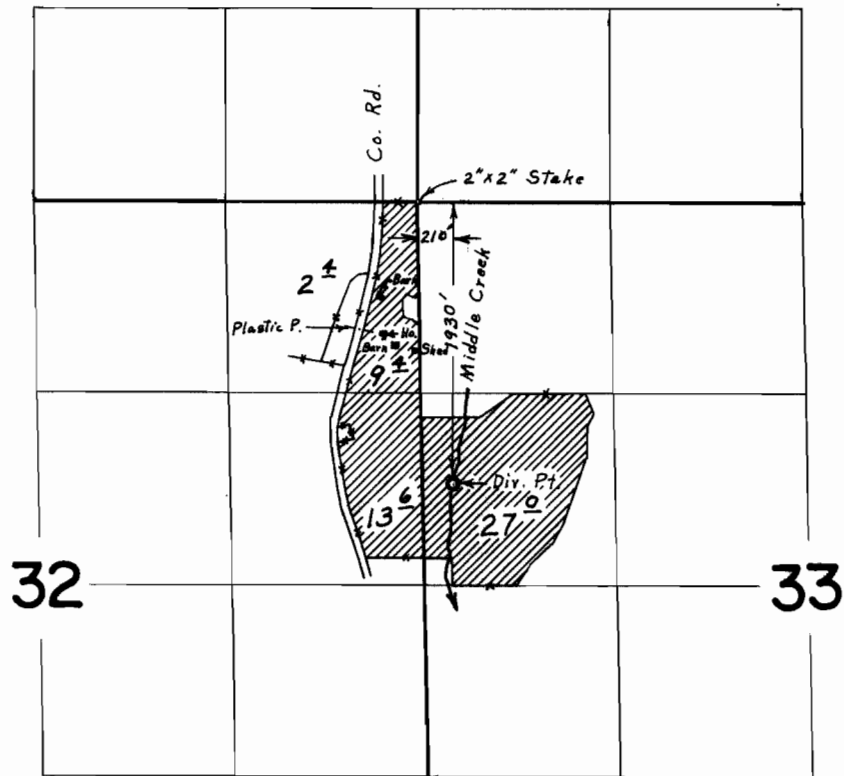

**FINAL PROOF SURVEY**  
UNDER

Application No. 39508 Permit No. 29321  
IN NAME OF

**EDWARD GRANT JOHNSON**

Surveyed May 16, 1967, by L. E. Gould