


T.5S.,R.6W.,W.M.

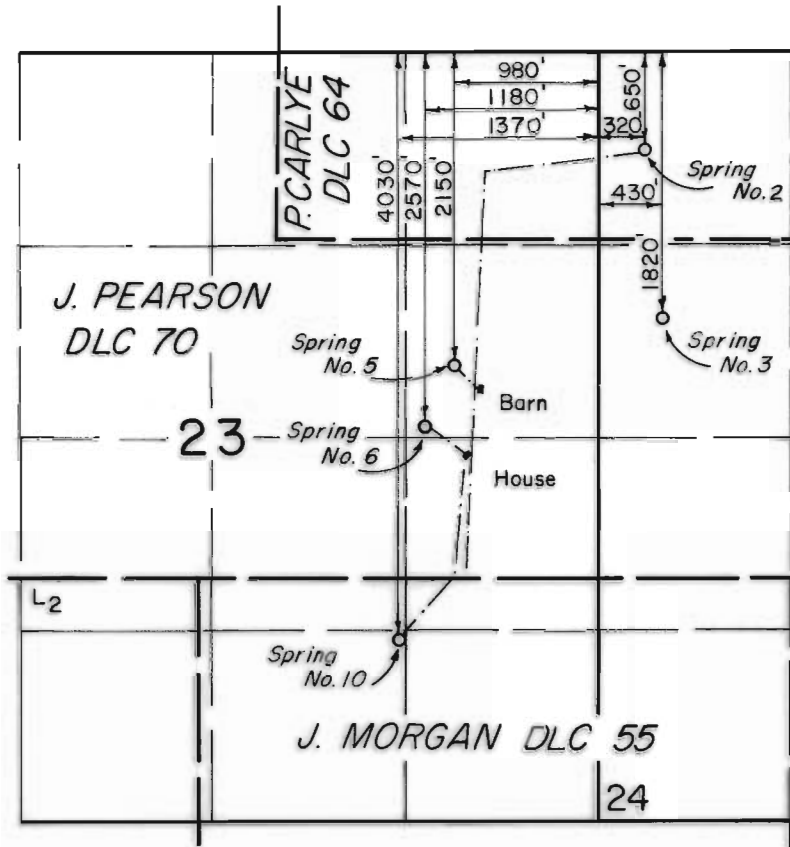

FINAL PROOF SURVEY

UNDER

Application No. 51015 Permit No. 38506
IN NAME OF

DONALD B. TSCHANZ

Surveyed AUG. 21, 1979, by J. Brown