


T.4S.R.10W.W.M.

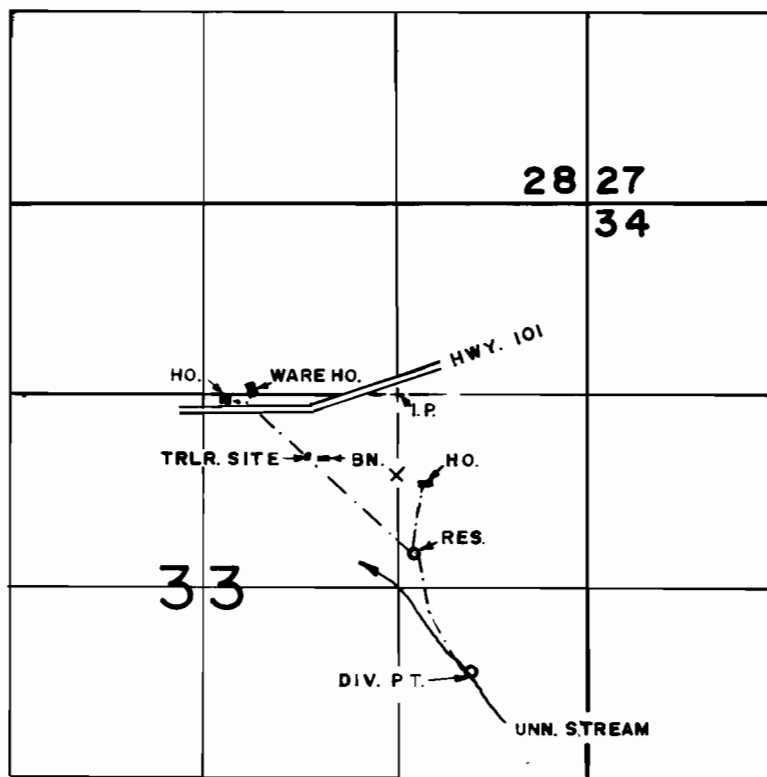

DIV. PT. LOC. : 1900' S. & 220' E. FROM CEN. NE. 1/4, SEC. 33

FINAL PROOF SURVEY UNDER

TRANSFER NO. 2428

Application No. Permit No.
IN NAME OF

TILLAMOOK PEOPLE'S UTILITY DISTRICT.....

Surveyed FEB. 14... 1980, by R.G. MUCKEN.....