


T. 39S., R. 35E., W. M.

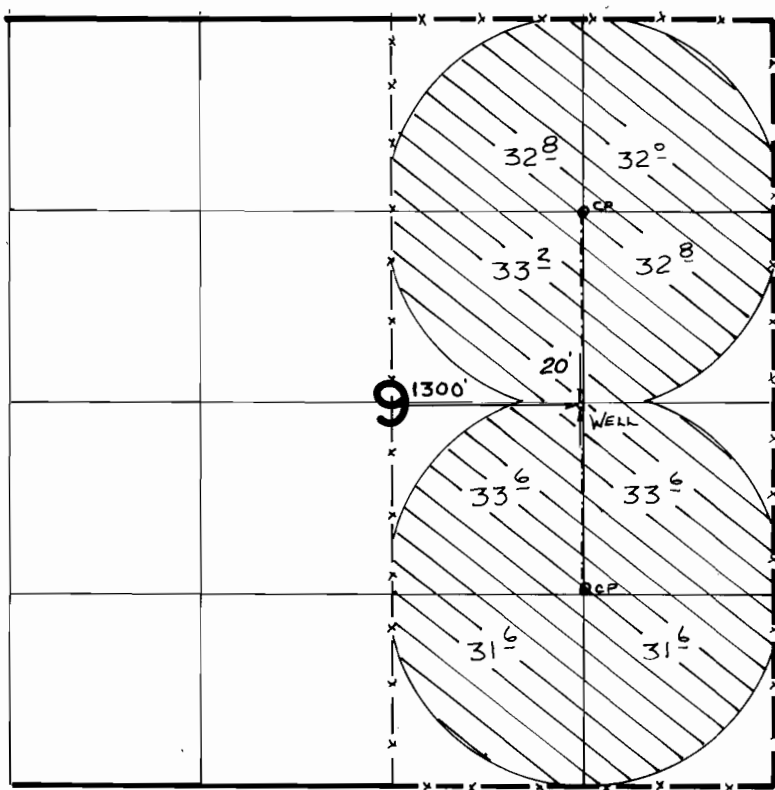

SCALE 1" = 1320'

FINAL PROOF SURVEY UNDER

Application No. **G7933** Permit No. **G7206**
IN NAME OF

DON S. ORLANDO & TRAVELERS INS. CO.

Surveyed 7-14 1988, by V.L. Church