


T.10S.,R.3W.,W.M.

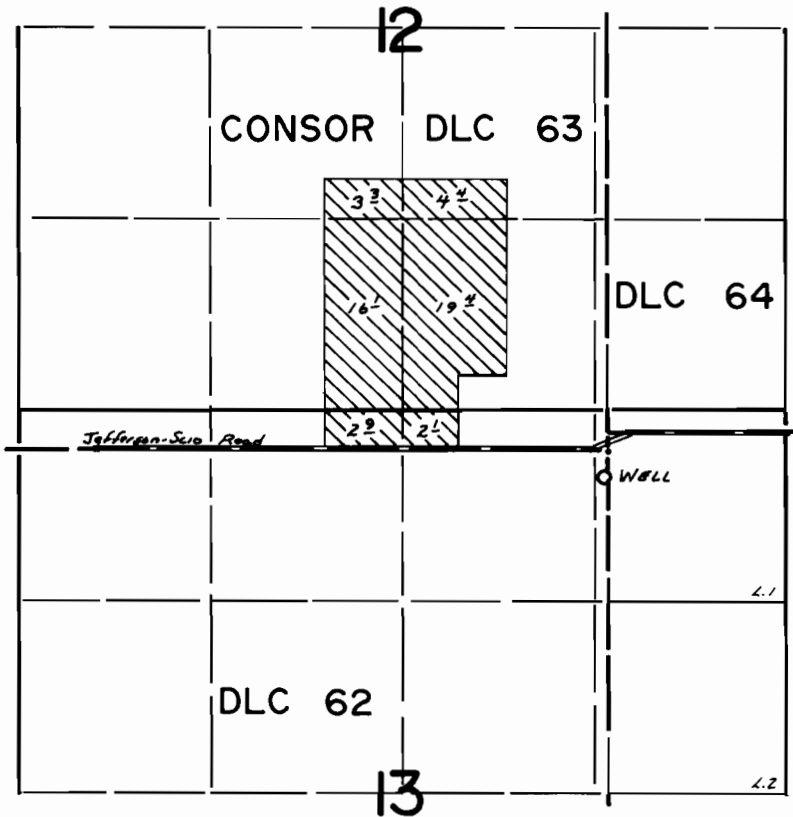

WELL LOCATION: 180 ft S AND 30 ft W from SE Cor. DLC 63

FINAL PROOF SURVEY UNDER

Application No. G-9292 Permit No. G-8826.....
IN NAME OF

LARRY W. WELLS

Surveyed Aug. 4, 1981, by L. TOLL.....