


T. 38S., R. 34E., W.M.

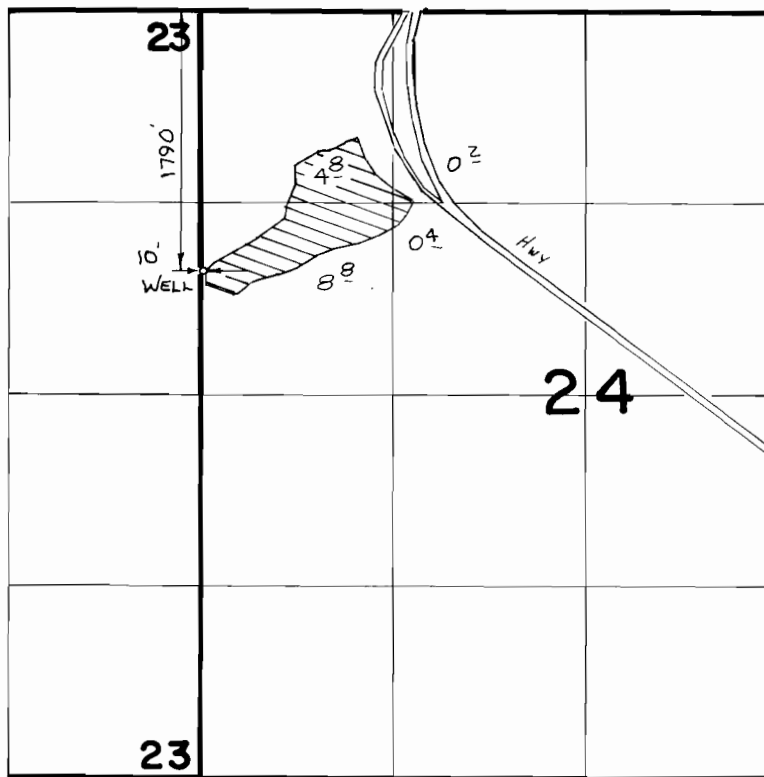

SCALE 1" = 1320'

FINAL PROOF SURVEY UNDER

Application No. **G:9305** Permit No. **G:8809**
IN NAME OF

KENNETH THOMPSON

Surveyed **7-14** 19**88**, by **V.L. Church**