


G-8723
66854

T.13S.,R.30E.,W.M.

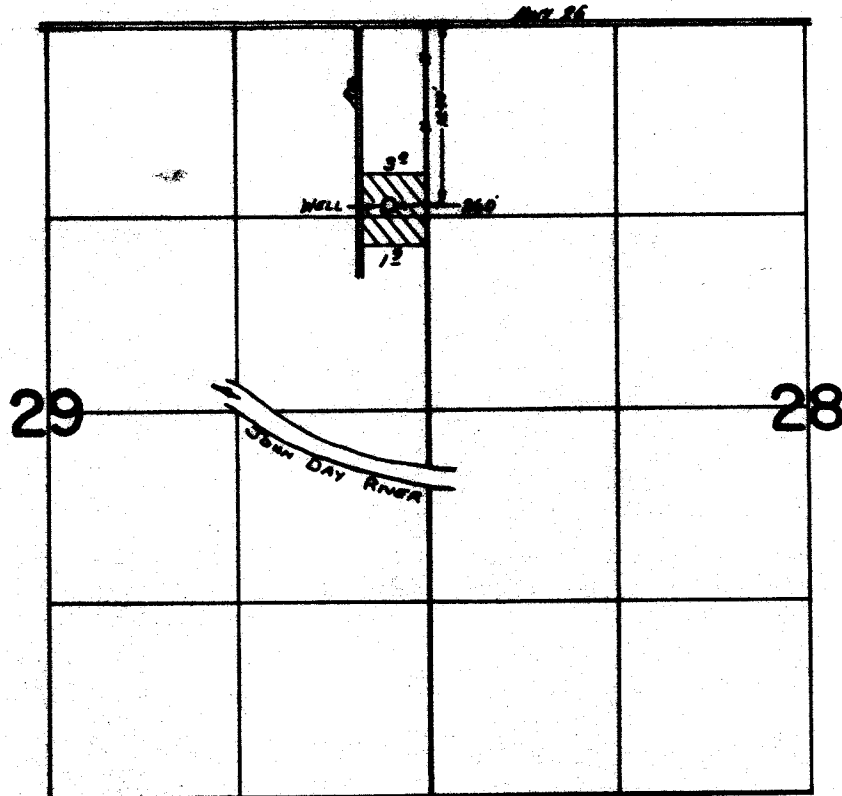

FINAL PROOF SURVEY UNDER

Application No. .G:9311.. Permit No. .G:8723.....
IN NAME OF

.....**WILBERT TAY**.....

Surveyed Aug.25... 19.83, by ..R..W..Cattel.....

PTS 4-1983-A 44