


G-8724
60355

T.13S.,R.31E.,W.M.
Section 22

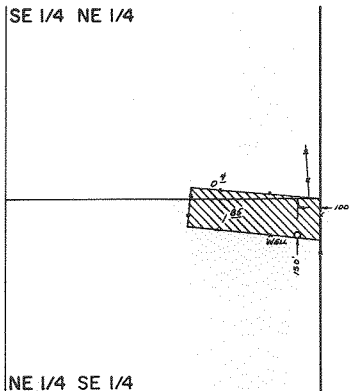

SCALE: 1" = 400'

FINAL PROOF SURVEY
UNDER

Application No. G-9323 Permit No. G-8724

IN NAME OF
MID COUNTY CEMETERY
MAINTENANCE DISTRICT

Surveyed Sept. 29, 1981, by S. C. BROWN