
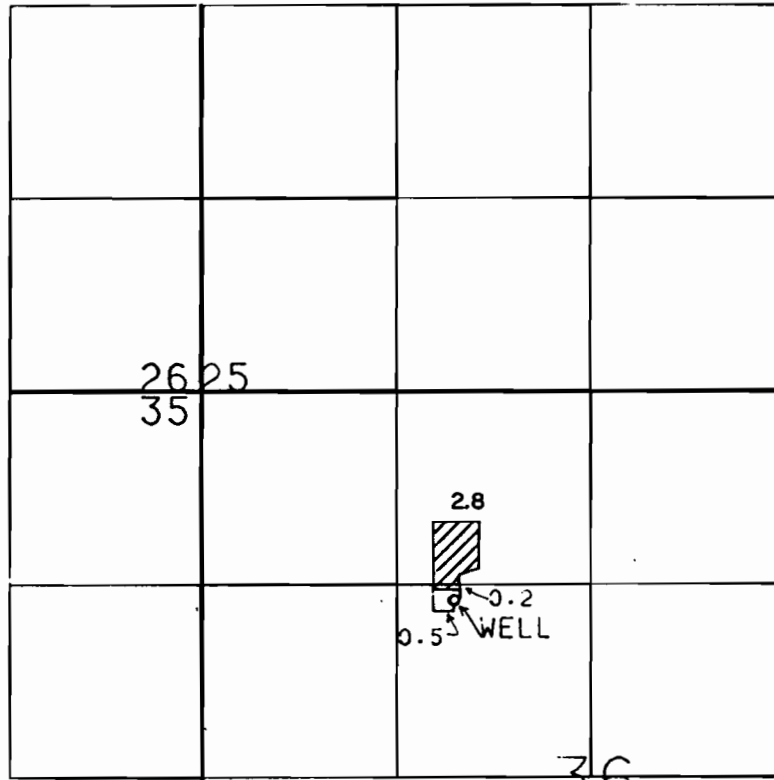


T. 18 S., R. 46 E., W.M.

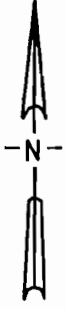

WELL LOC : 1430' S. & 1710' E. FROM NW COR. SEC. 36

SCALE: 1 IN = 1320 FT

FINAL PROOF SURVEY
UNDER

APPLICATION NO. G-9387

PERMIT NO. C-8807

IN THE NAME OF

JAY C. & AGNES M. BLAIR

SURVEYED MAR. 3

, 1986.

BY L. M. TOLL