


T.3S., R.2W., W.M.

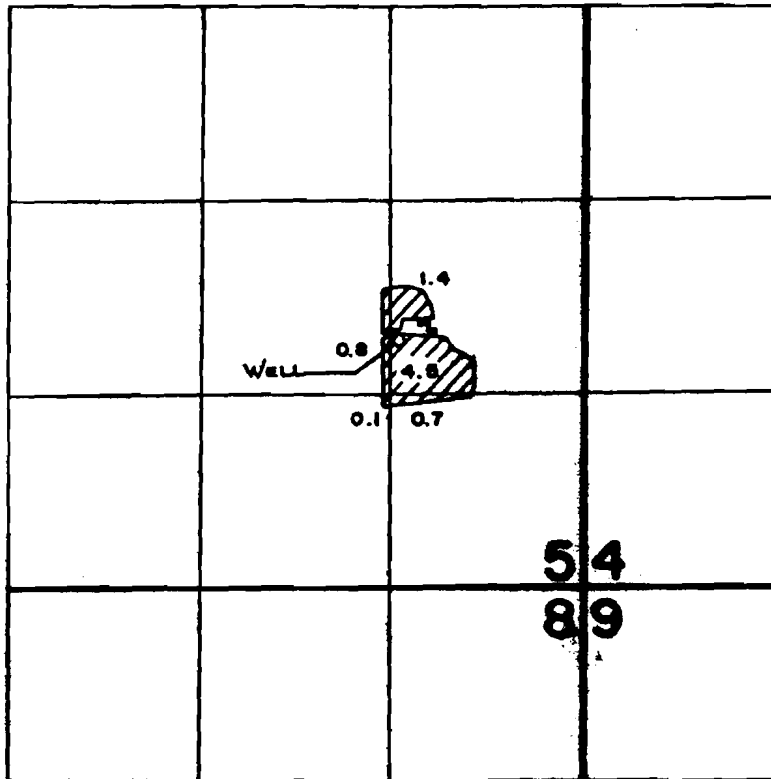

WELL LOCATION: 1670 FT. N. AND 1390 FT. E. FROM THE  
3/4 CORNER OF SECTION 5.



SCALE: 4" = 1 MILE

**FINAL PROOF SURVEY**  
UNDER

Application No. G-2431. Permit No. G-8921....  
IN NAME OF

.....GLENN R. BROWN.....

Surveyed NOV. 9, 1984, by P. Patten.....