


T.14S., R.13E., W.M.  
SW1/4 SW1/4 Sec.30

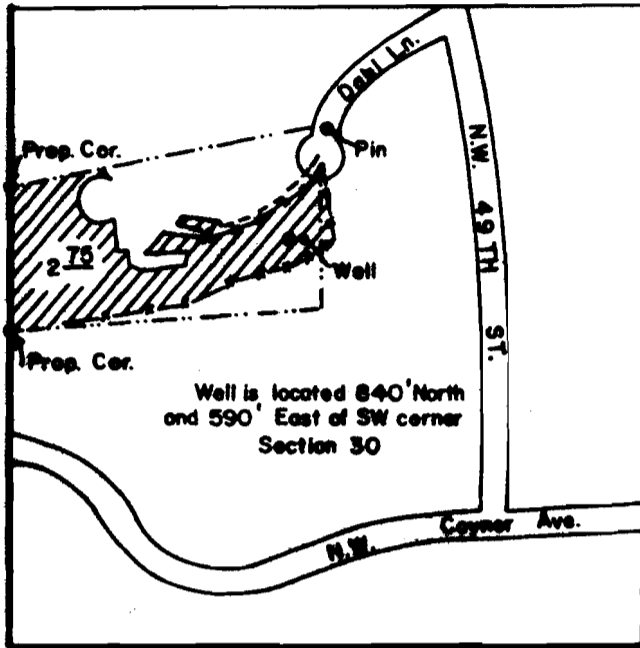

SCALE : 1" = 400'

**FINAL PROOF SURVEY**  
UNDER

Application No. G-9545 Permit No. G-8788 Cert. # 60861  
IN NAME OF

DOUGLAS C. WATSON

Surveyed OCT. 5 1983, by D. PANTHER

RECEIVED

DATE 5-23-89  
WATER MASTER DISTRICT #11  
BY SMJ

PTS II-1983-A LGO

G8788