


T. 36 S., R. 2 W., W.M.

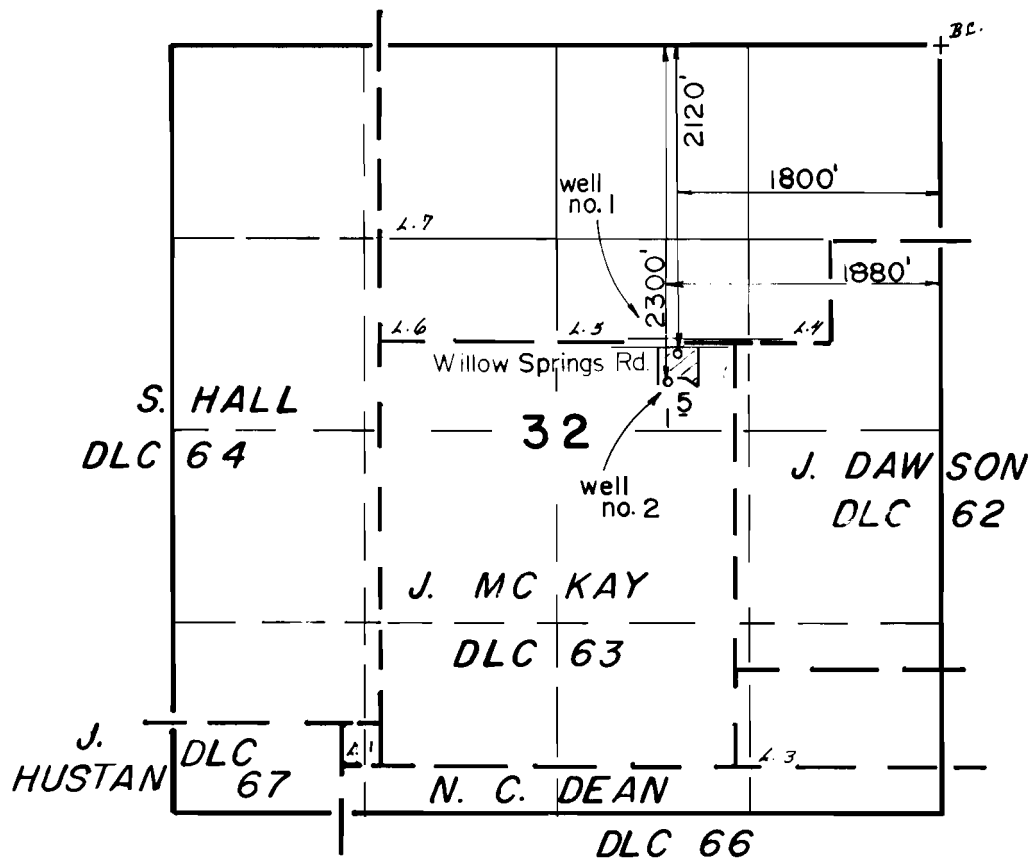

Scale: 1" = 1320'

FINAL PROOF SURVEY
UNDER

Application No. G-9651 Permit No. G-9035
IN NAME OF

EUGENE & TANYA FRANKLIN

Surveyed MAY 27 1986, by B. S. JAMES.