


T.15S.,R.4W.,W.M.

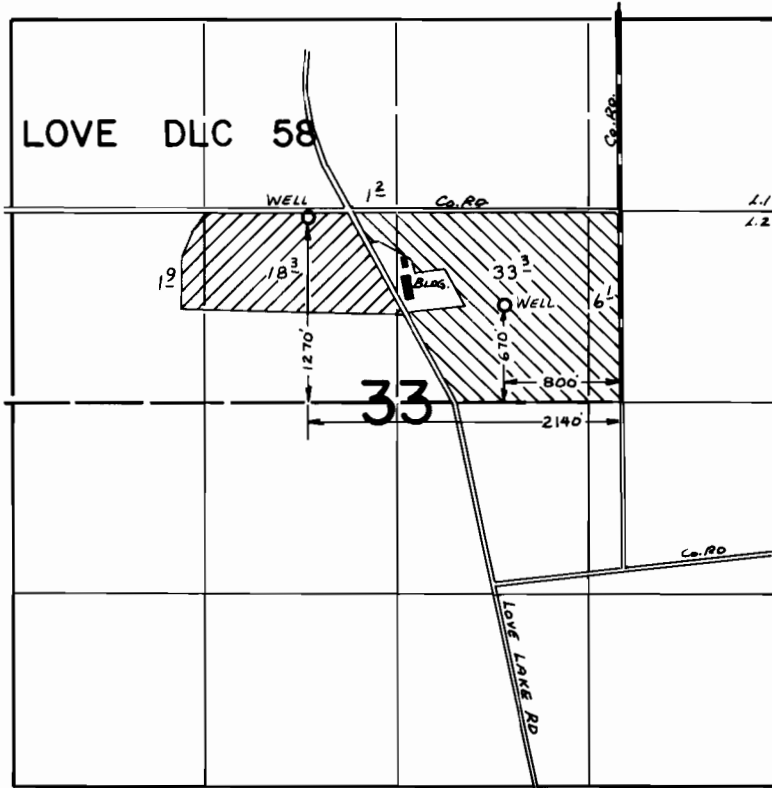

FINAL PROOF SURVEY UNDER

Application No. G-9653 Permit No. G-8949
IN NAME OF

.....DONALD BODTKER.....

Surveyed June 14, 1982, by L. M. TOLL.....