


T. 38 S., R. 1 W., W.M.

Sec. 18

NW 1/4 SW 1/4

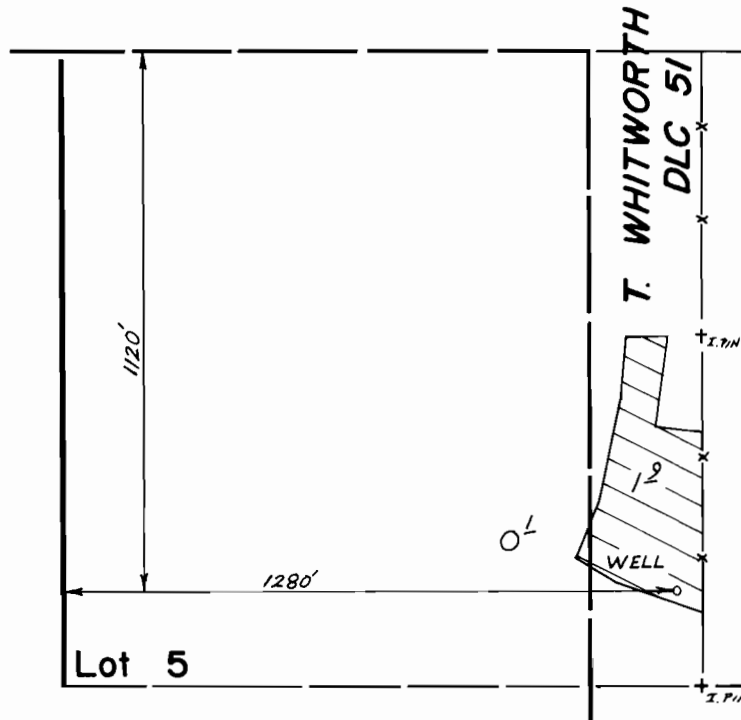

Scale 1"=400'

FINAL PROOF SURVEY
UNDER

Application No. G-10535 Permit No. G-9746
IN NAME OF

FREDRICK L. & GLENDA J. RIFFLE

Surveyed March 24, 1986, by B.S. JAMES