


T. 24S., R. 32 1/2E., W.M.

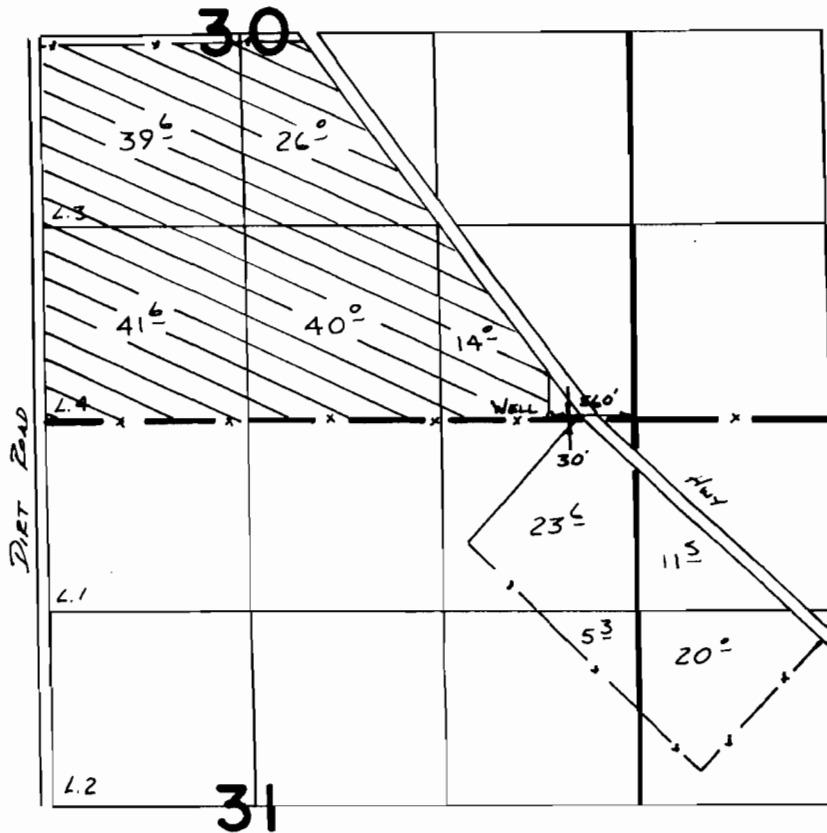

SCALE 1" = 1320'

FINAL PROOF SURVEY
UNDER

Application No. **G:11219** Permit No. **G:10340**
IN NAME OF

JETT C. BLACKBURN

Surveyed **5-9** 19**88**, by **V.L. Churek**