


T. 35 S., R. 2 W., W.M.

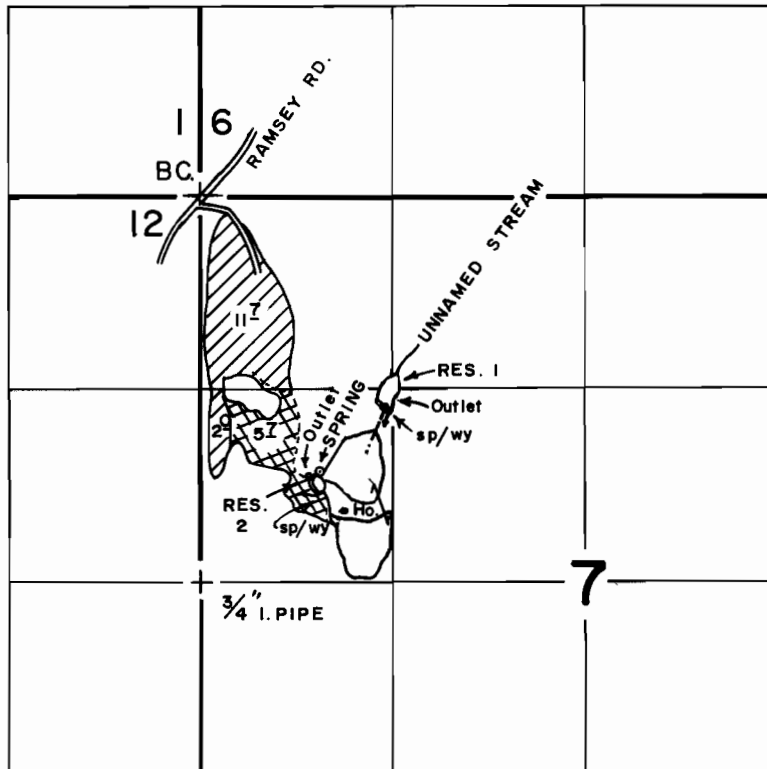

Spring Loc. : 750' N. & 820' E. from W. 1/4 Cor. Sec. 7.

▨ PRIMARY

▨ SUPP'L

FINAL PROOF SURVEY
UNDER

R-49285

R-5993

Application No. 49286. Permit No. 36937.....

IN NAME OF

EUGENE L. KIRKHAM.....

Surveyed JULY 22, 1982, by B. S. JAMES.....

Scale : 4" = 1 Mile