




T.28 S., R.11 W., W.M.

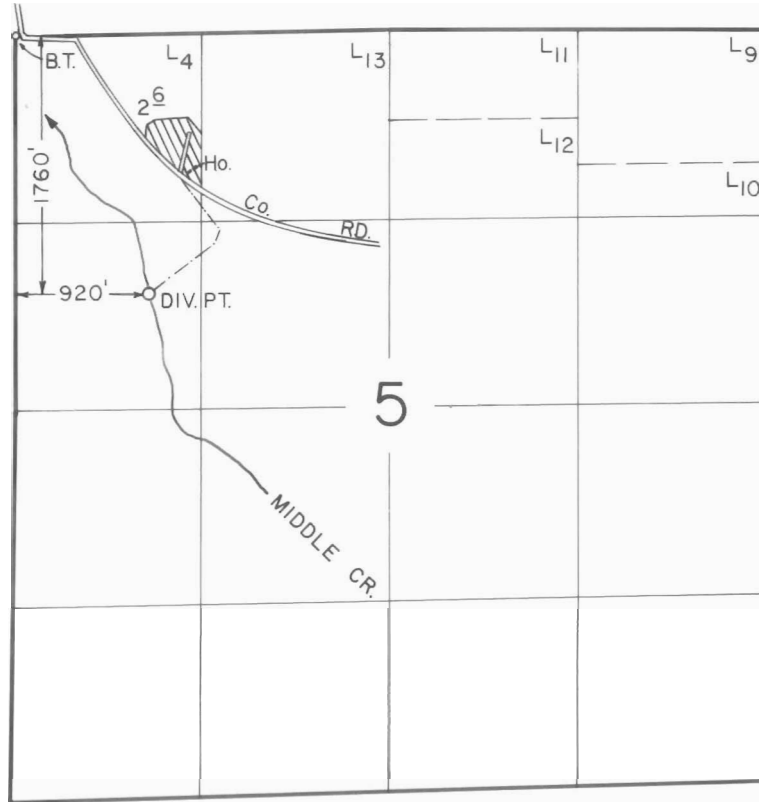

SCALE: 1" = 1320'

FINAL PROOF SURVEY
UNDER

Application No. 49635.. Permit No. 37173.....
IN NAME OF

.....RICHARD A. SHIELDS.....

Surveyed SEPT. 20 1988, by K.D. KEMP.....