




T.28 S., R.11 W., W.M.

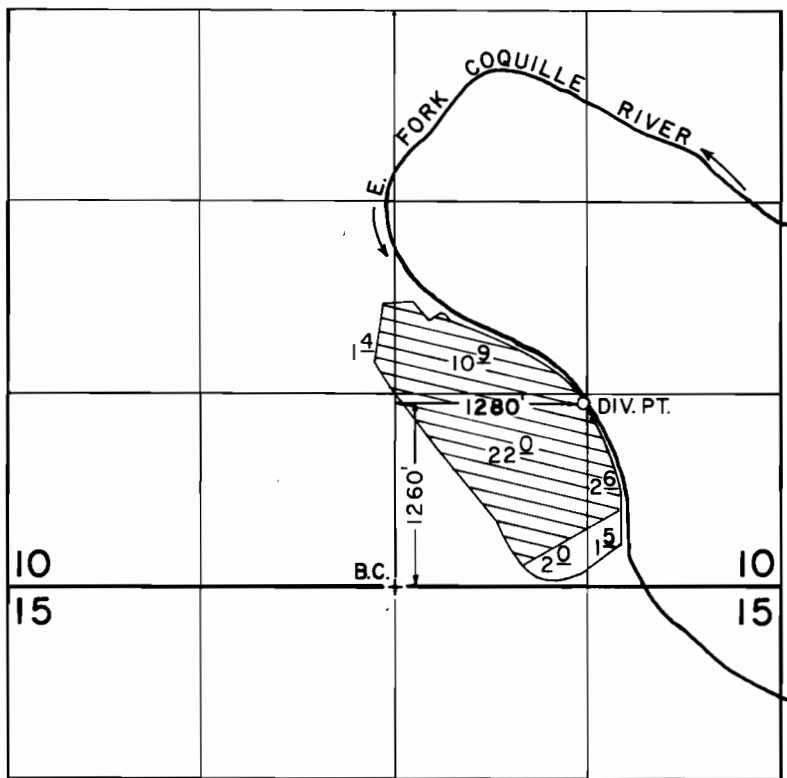

SCALE: 1" = 1320'

FINAL PROOF SURVEY
UNDER

Application No. 51264 Permit No. 38715.....
IN NAME OF

LAVERN C. & DOROTHY F. STAMAN

Surveyed SEPT. 17 1988, by B. S. JAMES.....