


T. 12S., R. 43E., W.M.

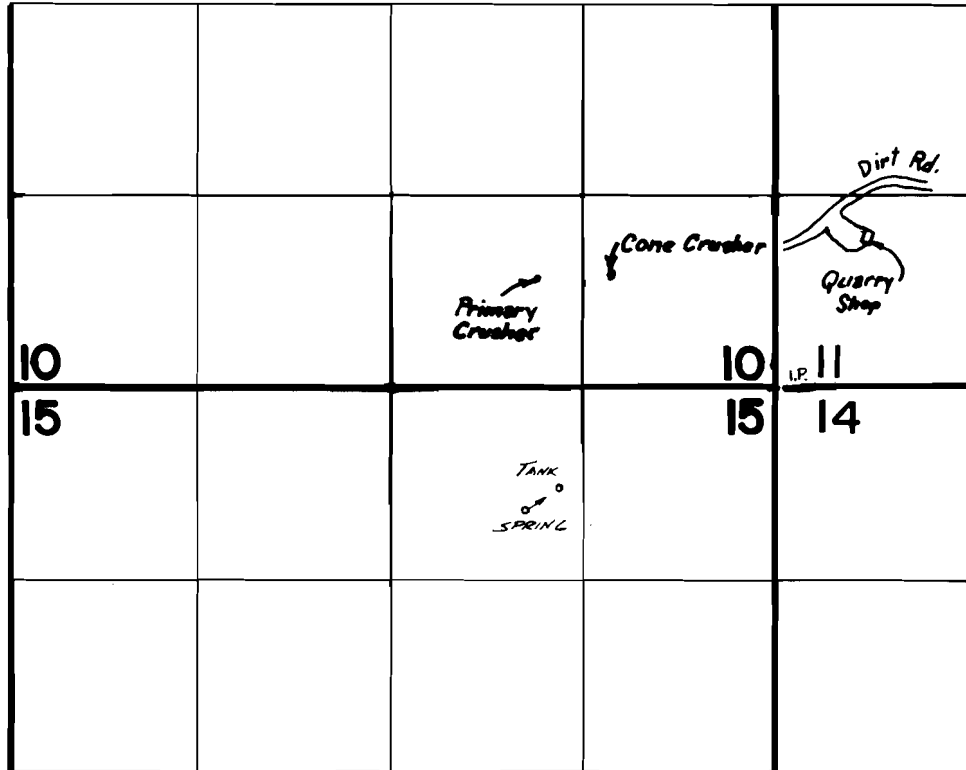

SPRING LOCATED 830'S & 1700' W. FROM NE COR SEC 15

FINAL PROOF SURVEY
UNDER

Application No. **52981** Permit No. **40305**
IN NAME OF

OREGON PORTLAND CEMENT COMPANY

Surveyed 11-1 1978, by R. BARWIN