9636

Sec. 22

Tp. 6S

R. 1W.

STATE ENGINEER
RECEIVED

JUL 1 1924

SALEM, OREGON
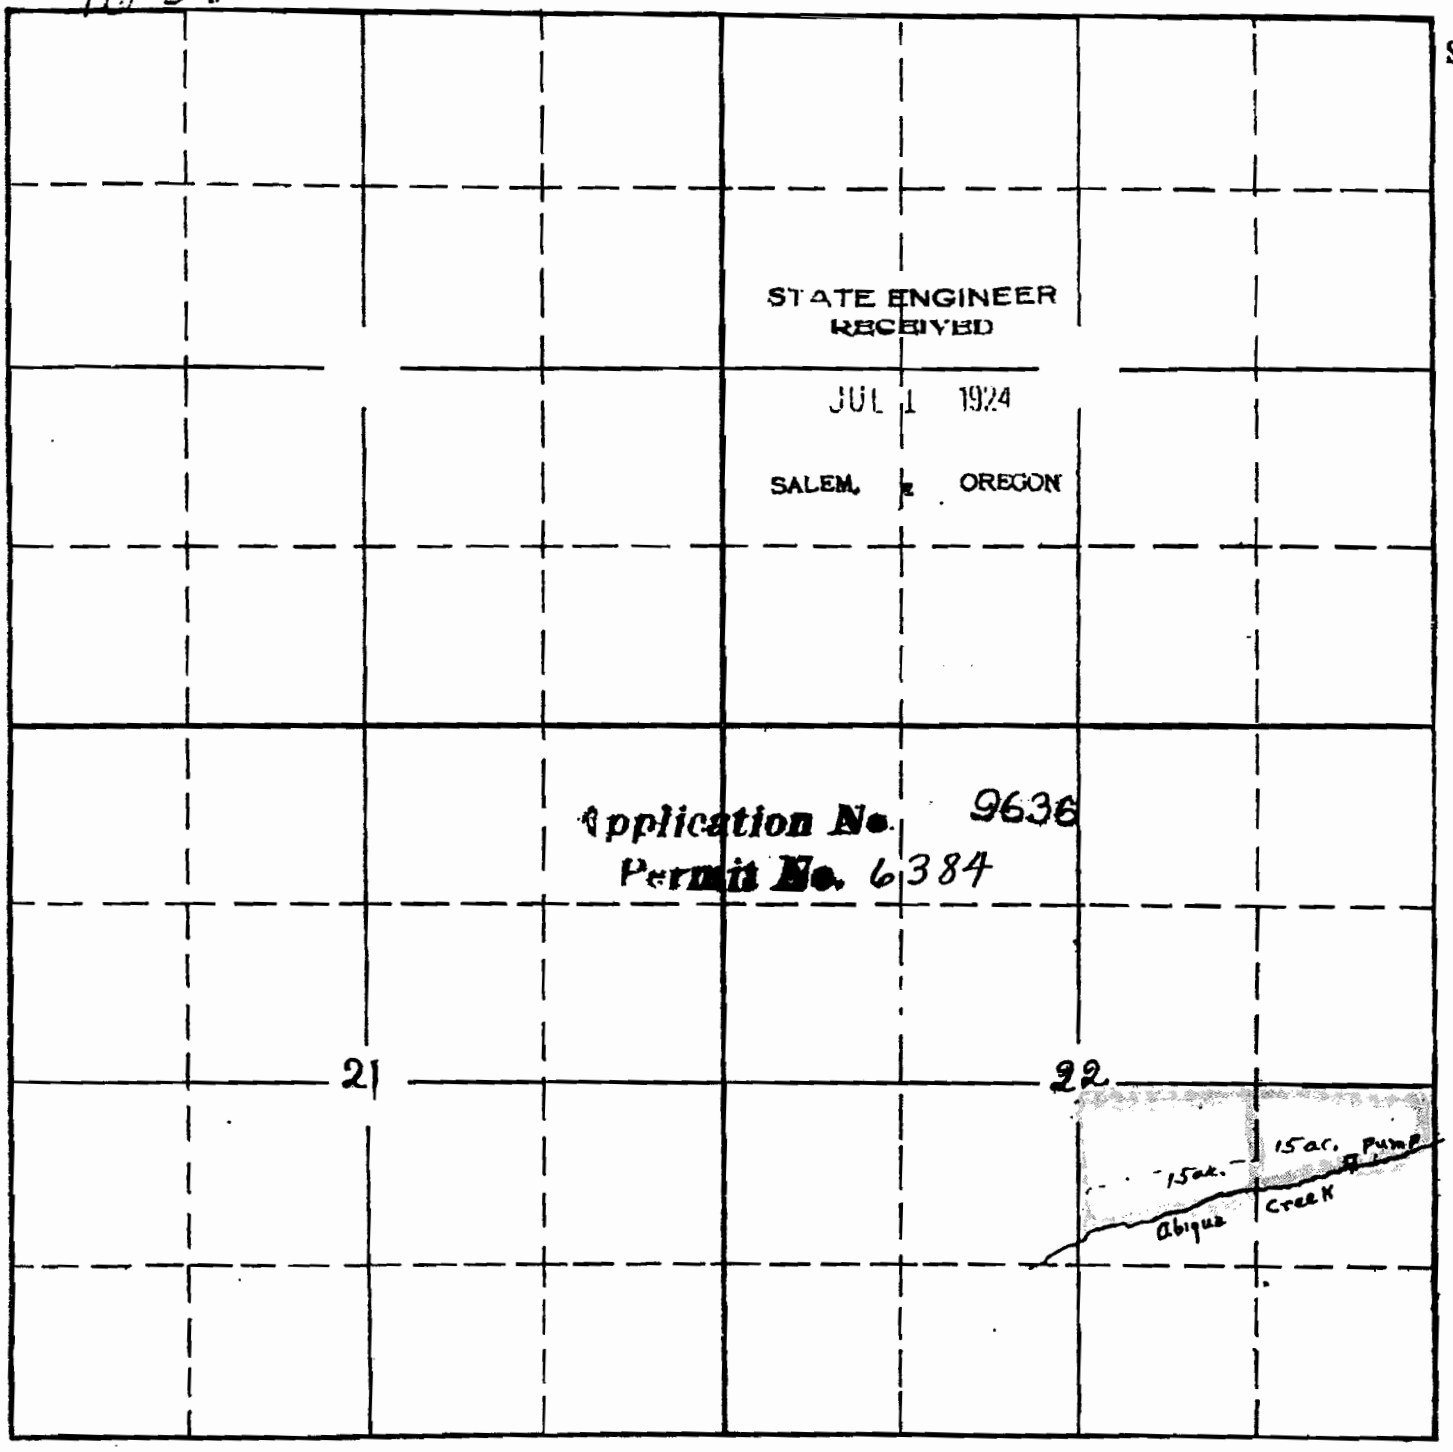
Application No. 9636
Permit No. 6384