




T.28S.,R11W.,W.M.

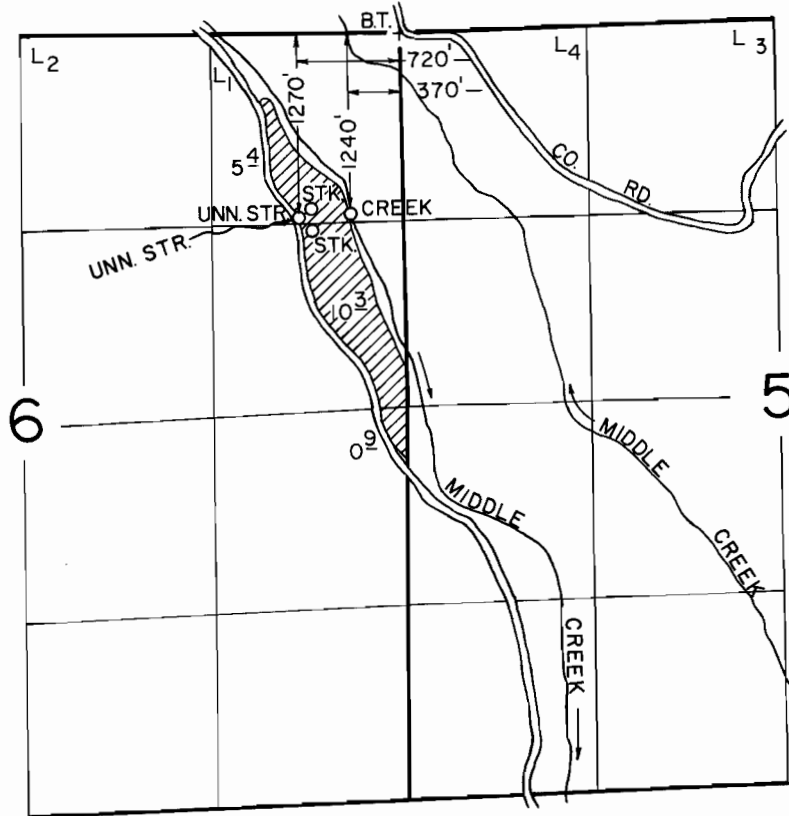

SCALE: 1" = 1320'

FINAL PROOF SURVEY UNDER

Application No. 55091... Permit No. 41453.....
IN NAME OF

..... EDWARD H. HARTER

Surveyed SEPT. 20 1988, by B. S. JAMES