


RECEIVED

FEB 17 1977

UNITED STATES DEPT. OF
INTERIOR BUREAU OF LAND
MANAGEMENT OREGON

T.5S.R.5W.W.M.

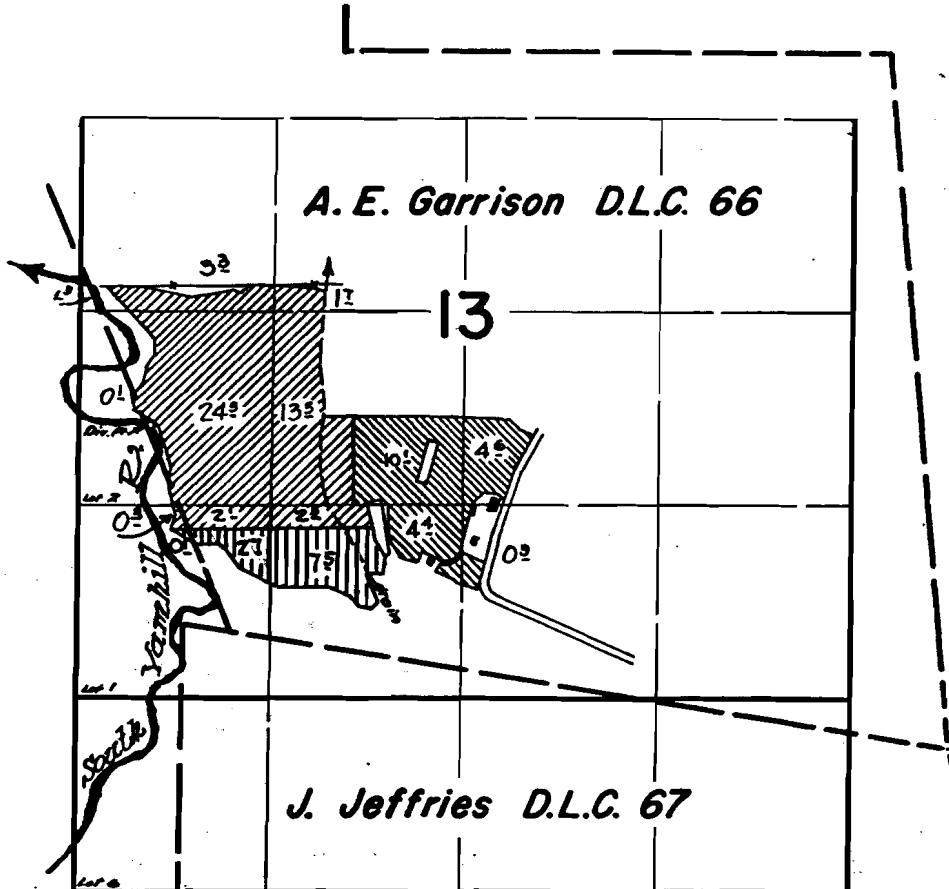

Diversion point is located 2180 ft North and
5480 ft. West from S.E. Cor. D.L.C. 66

FINAL PROOF SURVEY
UNDER

Application No. ~~37316~~ Permit No. ~~27790~~
IN NAME OF

RUSSELL SHELDON

Surveyed August 7, 1967, by *R. Jackson*
55259
43573

\$ 20 00
24 70
44 70

Application No.
Permit No.