




T. 25 S., R. 11 W., W.M.

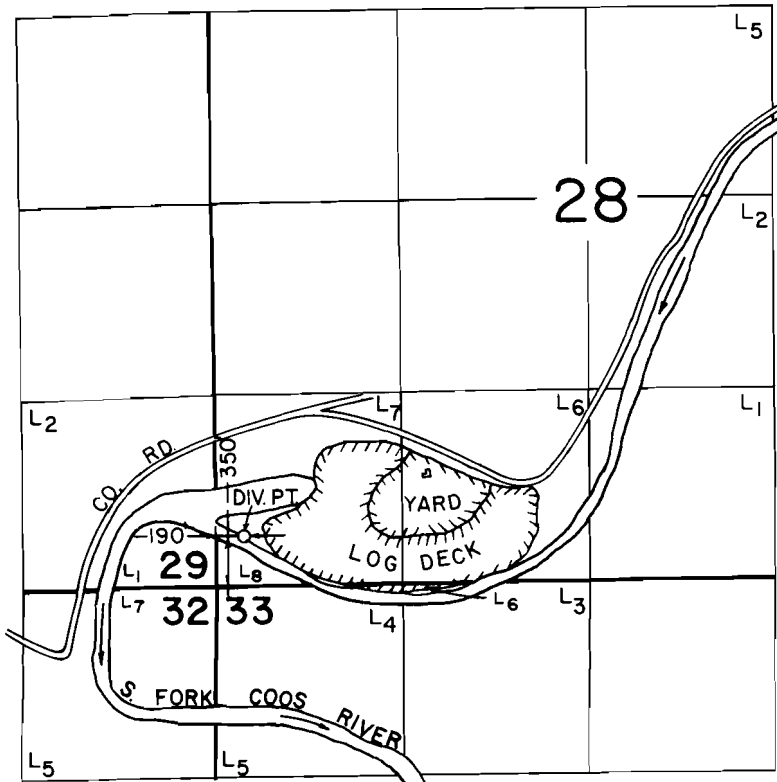

SCALE: 1" = 1320'

FINAL PROOF SURVEY
UNDER

Application No. 55664.. Permit No. 41698.....
IN NAME OF

WEYERHAEUSER COMPANY

Surveyed SEPT. 19. 1988., by B. W. BISHOP.....