


ENGINEERS • PLANNERS

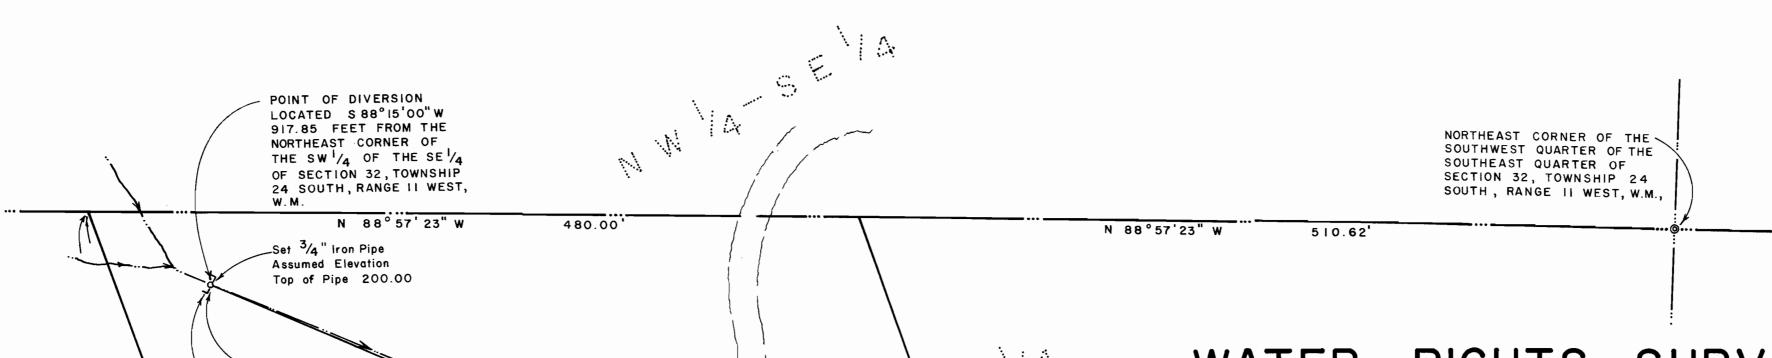

Center of Creek

## WATER RIGHTS SURVEY


LOCATED IN A PORTION OF THE SOUTHWEST QUARTER OF THE SOUTHEAST QUARTER OF SECTION 32, TOWNSHIP 24 SOUTH, RANGE II WEST, W.M., COOS COUNTY, OREGON

SCALE | " = 60'

APRIL 22,1977

FOR:

TOM BIAS BOX 512 COOS RIVER RT. COOS BAY, OREGON 97420

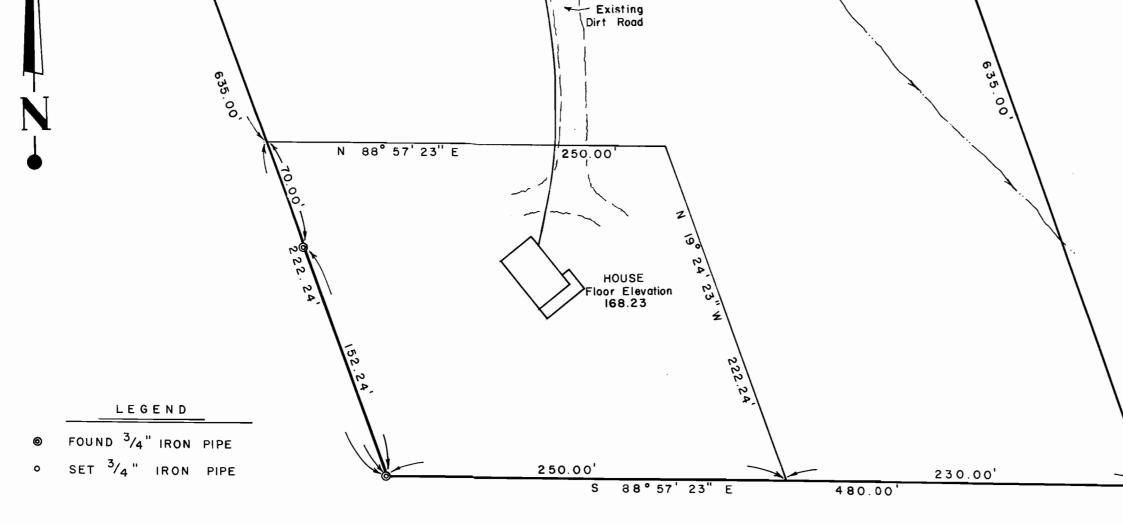

= 12" Concrete — Culvert

Elevation of Creek

Bottom at POINT

OF DIVERSION 197.20

PROPOSED DAM

Concrete

12 ft. wide 5 ft. high

2" Dia. PVC PIPE

PROPOSED WATERLINE -

Total Length 535 ft. ±

REGISTERED
PROFESSIONAL
LAND SURVEYOR

OREGON
OCTOBER 4, 1987
ROBERT W. WADE
433

Application No. 5k 79 Permit No. 42086

