


T. 39 S., R. 8 W., W.M.

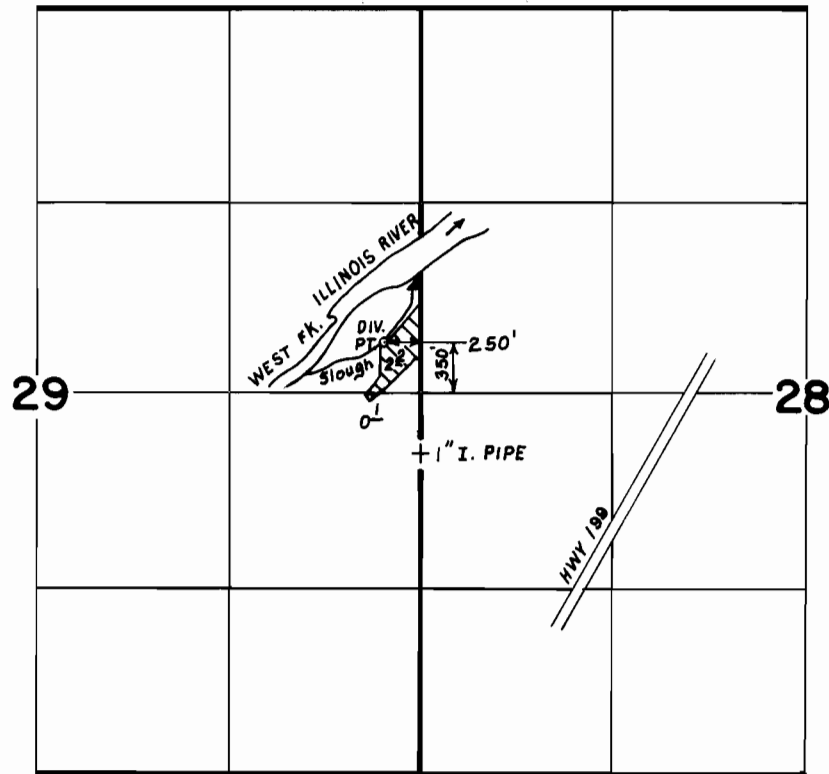

SCALE: 1" = 1320'

**FINAL PROOF SURVEY**  
UNDER

Application No. **56194** Permit No. **42279**  
IN NAME OF

.....*ROBERT R. WEBB*.....

Surveyed **MAR. 27** 19**84**, by **B. S. JAMES**.....