




T. 25 S., R. 11 W., W.M.

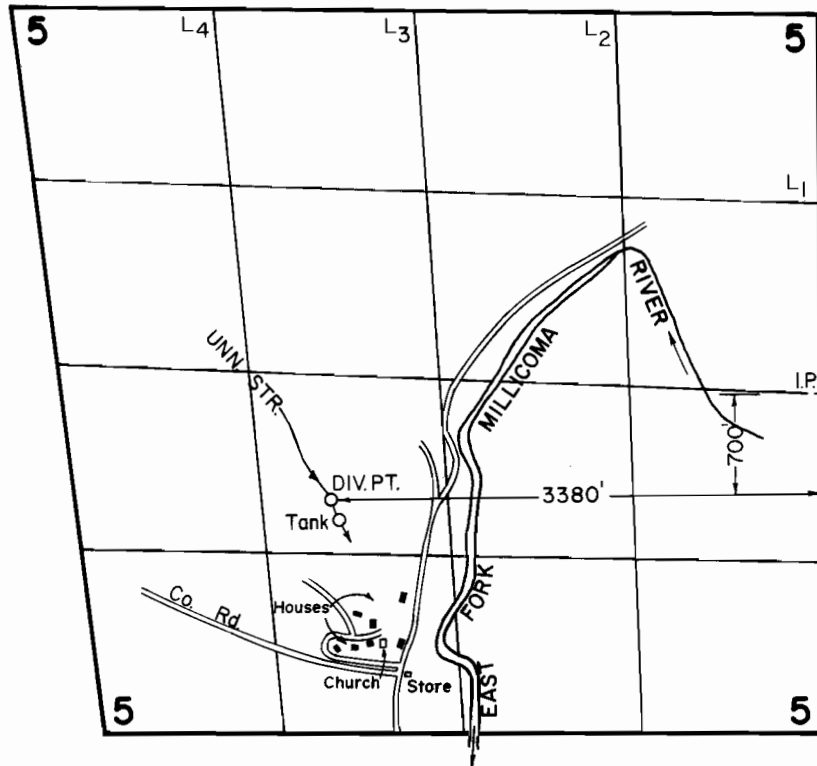

SCALE: 1" = 1320'

FINAL PROOF SURVEY
UNDER

Application No. 56250 Permit No. 42298
IN NAME OF

ALLEGANY DISTRICT IMPROVEMENT COMPANY

Surveyed SEPT. 17, 1988, by B. W. BISHOP