


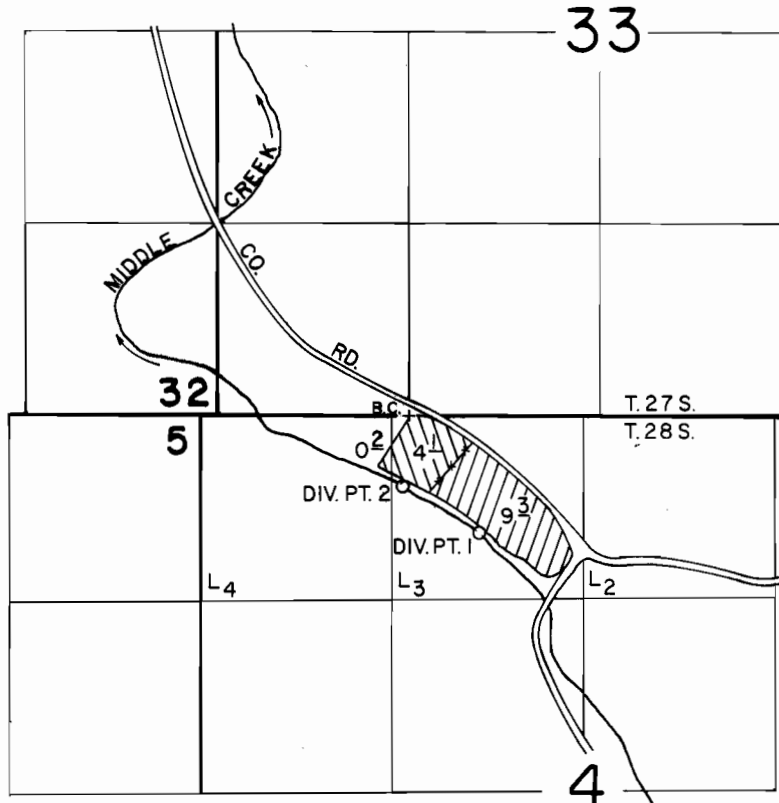


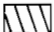
T.27 & 28 S., R.11 W., W.M.



DIV. PTS LOC: "1- 800'S. & 490'E., "2- 480'S. & 50'W., BOTH FROM SW CORNER, SE 1/4 SW 1/4 SECTION 33.

SCALE: 1" = 1320'

FINAL PROOF SURVEY
UNDER

 DIV. PT. 1
 DIV. PT. 2

Application No. 57192... Permit No. 43020.....
IN NAME OF

JOHN A. FREDRICKSON

Surveyed SEPT. 18, 1988, by B. S. JAMES.....