


# T6S. R3 & 4W. WM.

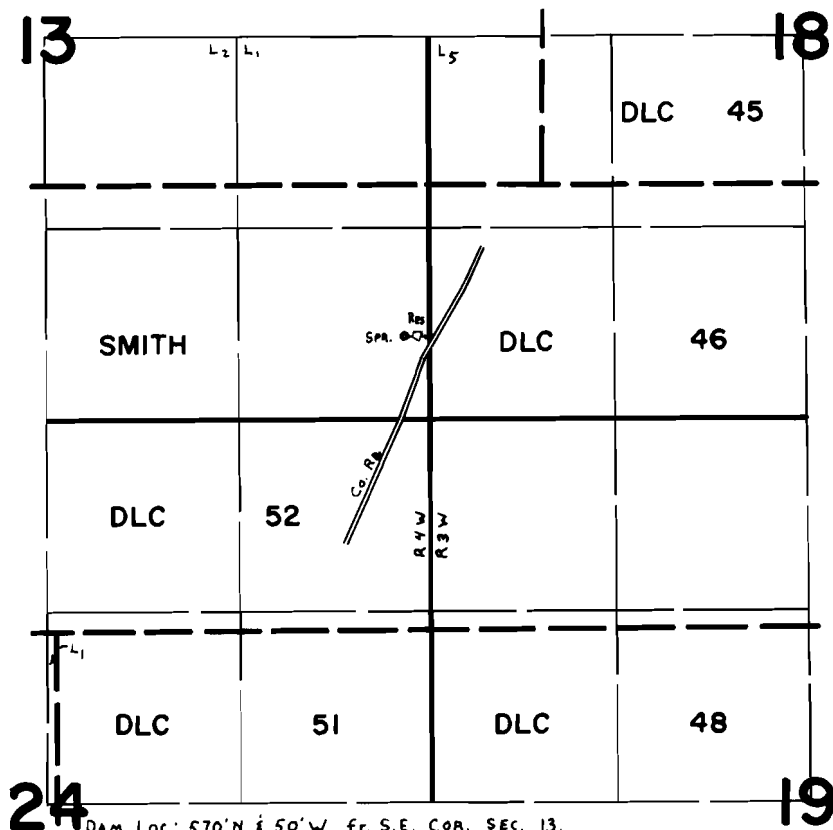

DAM LOC: 570' N. & 50' W. fr. S.E. COR. SEC. 13.  
 SPRING LOC: 570' N. & 150' W. fr. S.E. COR. SEC. 13.

## FINAL PROOF SURVEY UNDER

57357                      43302  
 Application No. R-57356 Permit No. R-7670.....  
 IN NAME OF

**JOHN A. REESE, JR.**

Surveyed May 15, 1979, by C. L. HUGHES.