


# T.7S.,R.4W.,W.M.

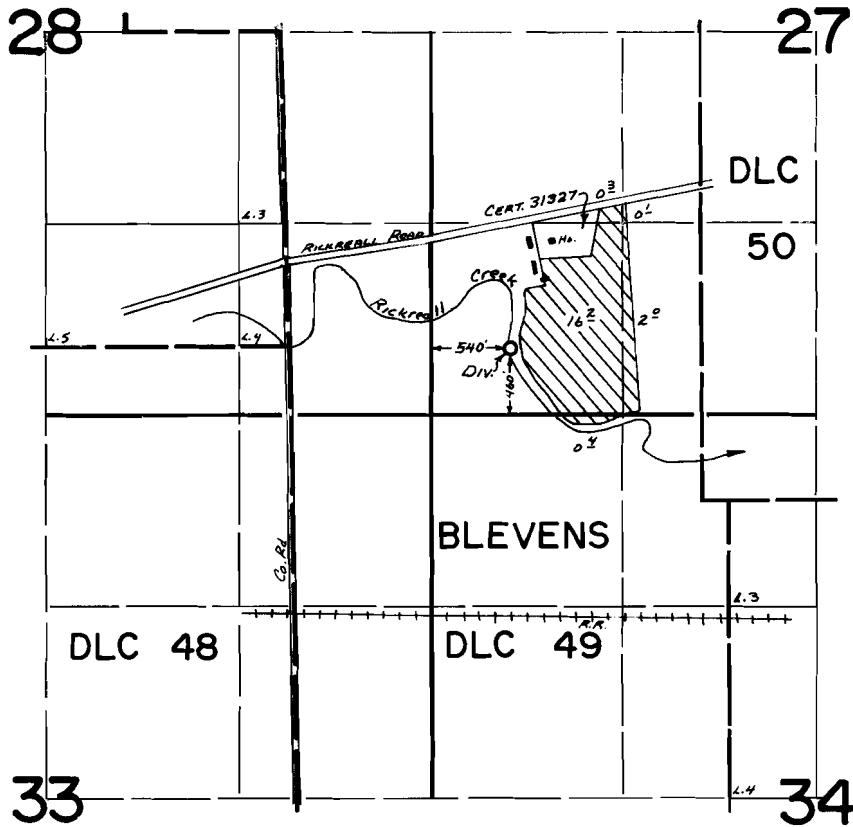

## FINAL PROOF SURVEY UNDER

Application No. 57668. Permit No. 4339!.....  
IN NAME OF

.....RAYMOND T. RHODES.....

Surveyed Nov....2... 19.81., by ..S..G...BROWN....