


T. 3 N., R. 9 W., W.M.

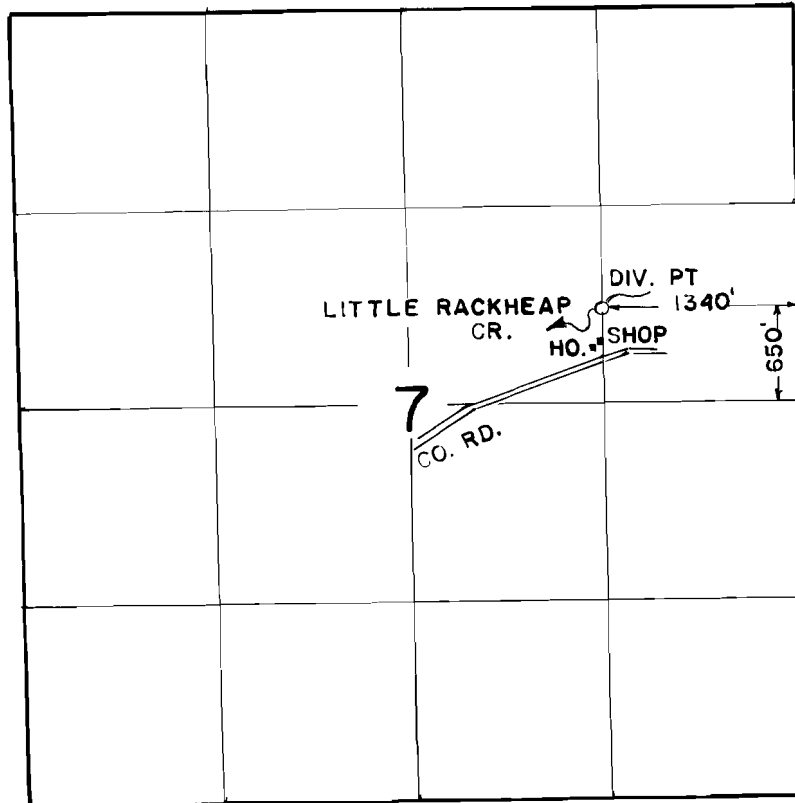

SCALE
1" = 1320'

FINAL PROOF SURVEY
UNDER

Application No. 57700 Permit No. 43373

IN NAME OF

ROBERT H. GRAZER

Surveyed MAY 23 1984, by P. PAGTER