


T. 26 S., R. 4 W., W.M.

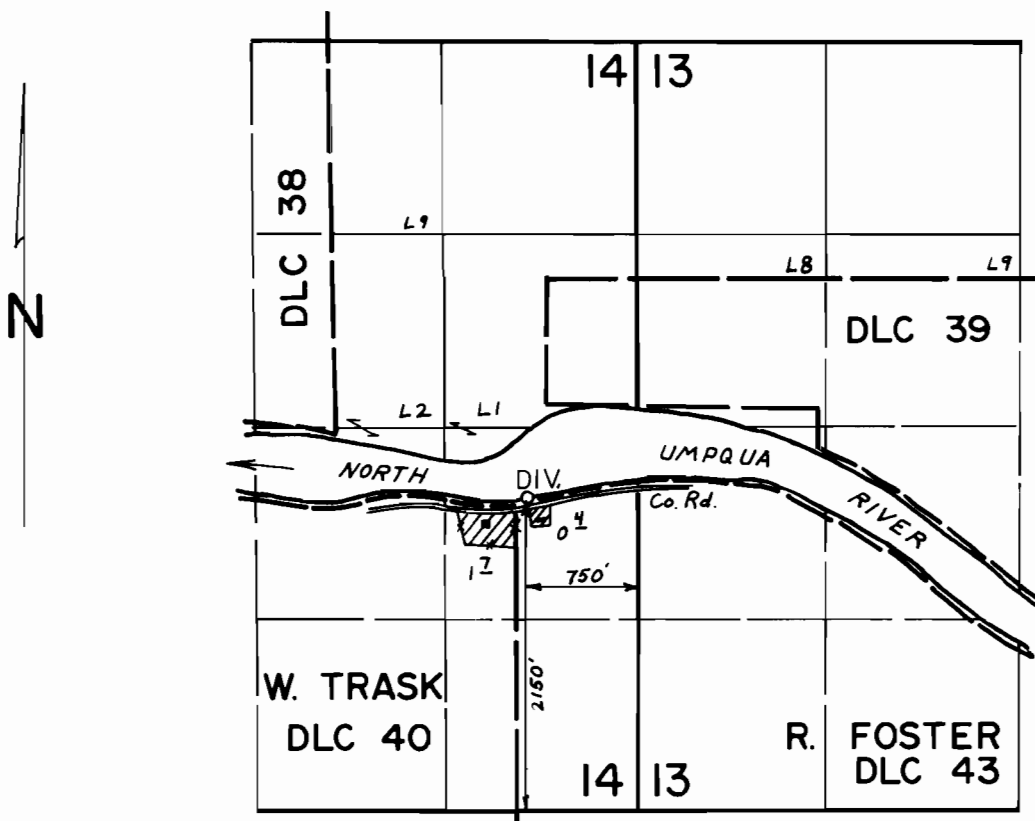

SCALE: 4" = 1 mile

FINAL PROOF SURVEY
UNDER

Application No. 57.720.. Permit No. 43484.....
IN NAME OF

.....**WAYNE & CAROLE BRADY**.....

Surveyed AUG...28, 19.84, by *J. Cashion*.....