




T.25S.,R.11W.,W.M.

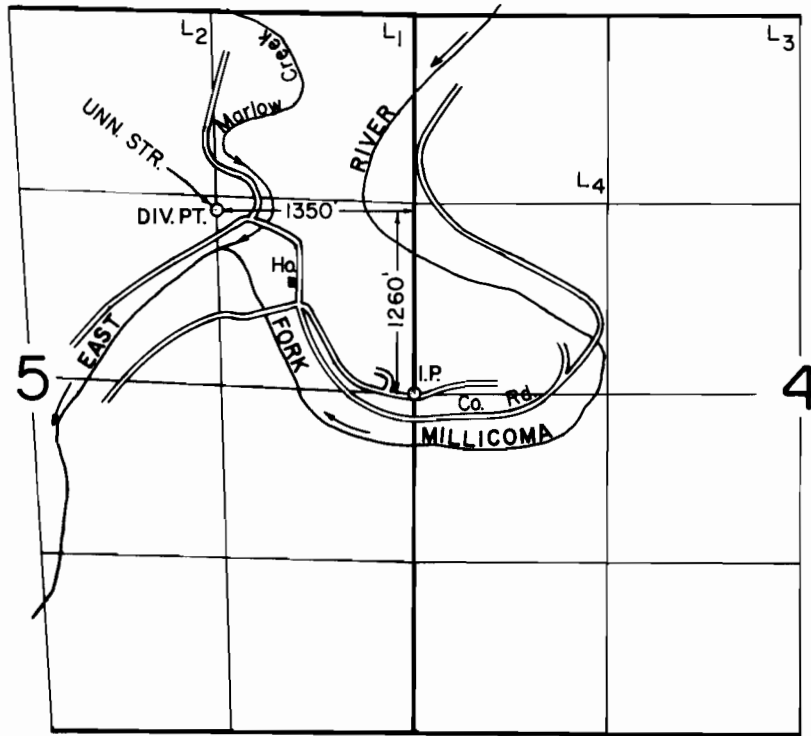

SCALE: 1" = 1320'

FINAL PROOF SURVEY
UNDER

Application No. 58228 Permit No. 43907
IN NAME OF

REED L. TERRY

Surveyed SEPT. 17, 1988, by B. W. BISHOP