




T. 25 S., R. 11 W., W.M.

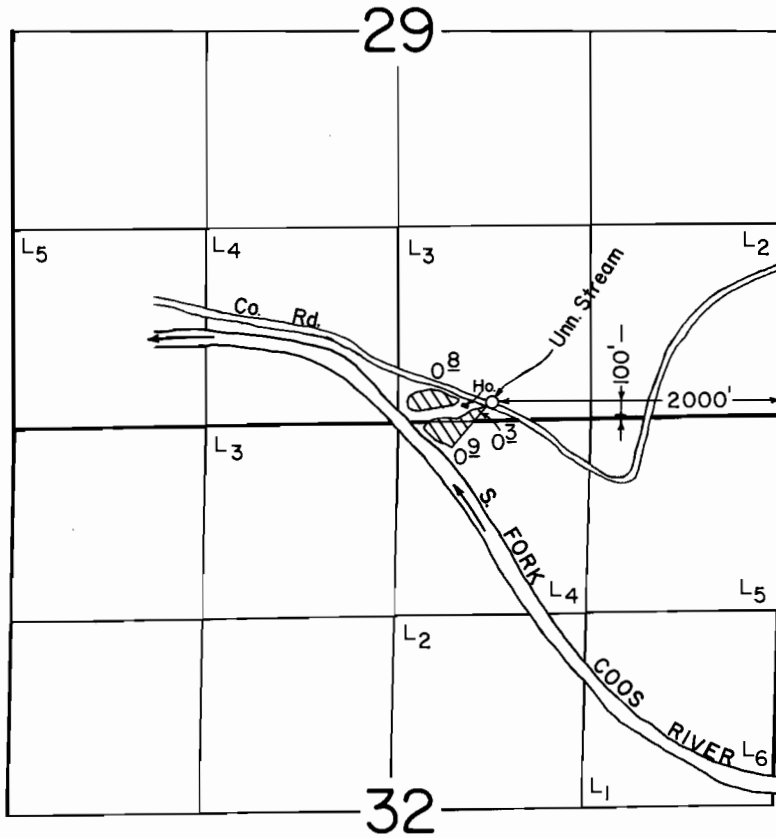

SCALE: 1" = 1320'

**FINAL PROOF SURVEY**  
UNDER

Application No. 58384 Permit No. 44077  
IN NAME OF

**FLOYD BUFORD**

Surveyed SEPT. 18, 1988, by B. W. BISHOP