




T. 25 S., R. 11 W., W.M.

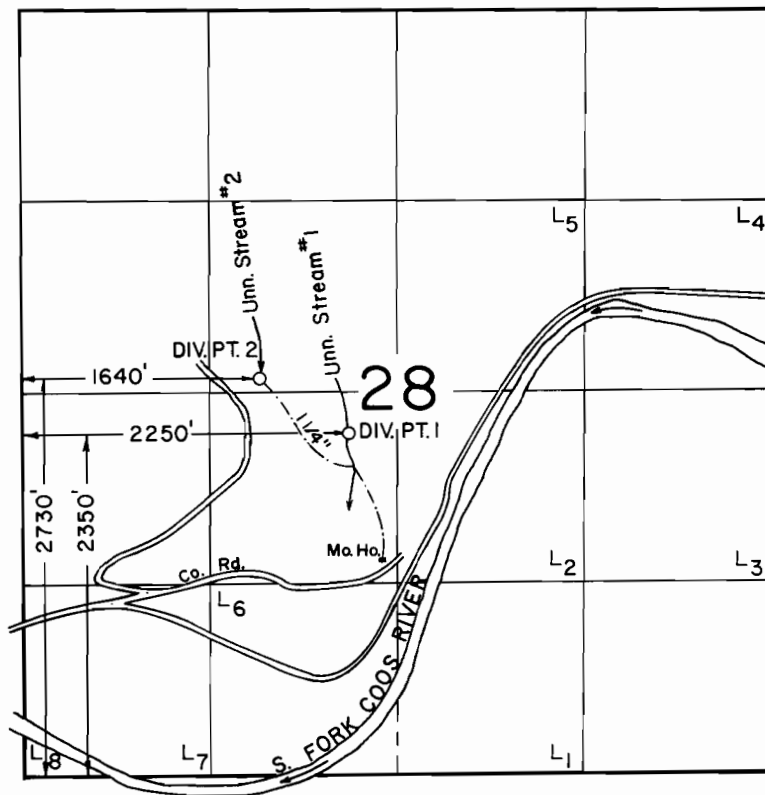

SCALE: 1" = 1320'

# **FINAL PROOF SURVEY** UNDER

Application No. 60110... Permit No. 44866...  
IN NAME OF

**DONALD J. & OR TOMMIE M. MARCOTT**

Surveyed SEPT. 18, 1988, by B. W. BISHOP