


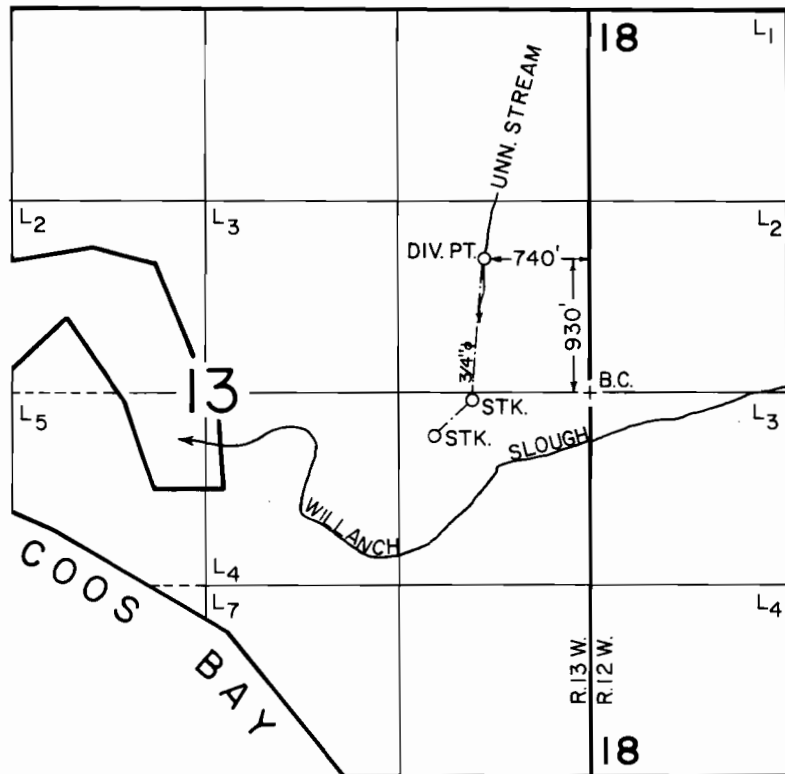

T. 25 S., R. 12 & 13 W., W.M.



SCALE: 1" = 1320'

**FINAL PROOF SURVEY**  
UNDER

Application No. 60354.. Permit No. 45665.....  
IN NAME OF

.....DON & GLORIA J. HALL.....

Surveyed SEPT. 21. 1988., by B. W. BISHOP.....