


T3S. R4E. W.M.

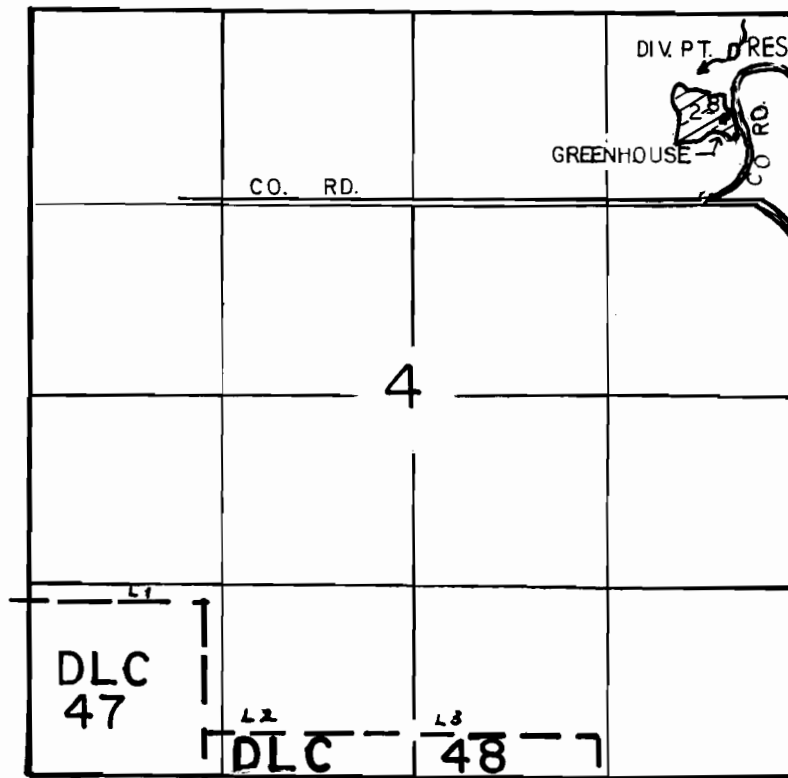

DIV. PT. LOCATED 450' W. AND 350'S. FROM THE N.E. COR. SEC. 4

SCALE: 1" = 1320'

FINAL PROOF SURVEY UNDER

R-60370 R-8462
Application No. 60371 Permit No. 46839
IN NAME OF

CRAIG ALAN BENSON

Surveyed AUG. 24.. 1987., by T.M. WARREN.....