90684

N

T. 28 S., R. 11 & 12 W., W.M.

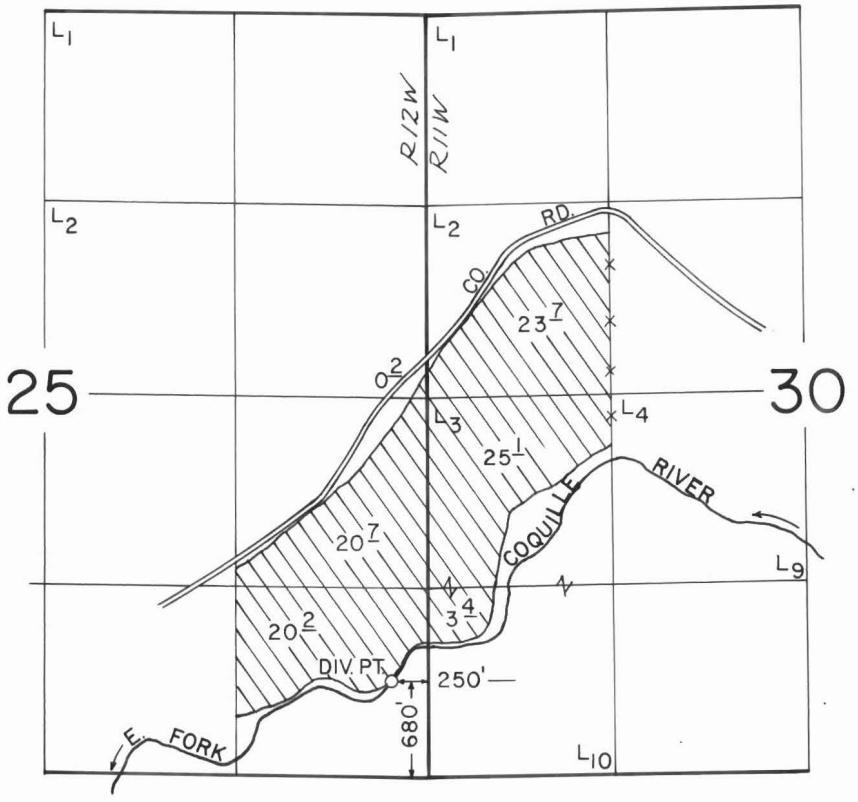

SCALE: 1" = 1320'

FINAL PROOF SURVEY

UNDER

Application No. 60669 Permit No. 45548

IN NAME OF

P. A. CULBERTSON

Surveyed SEPT. 21 1988, by B. S. JAMES

COB-3HH-144