


T.13S.,R.3W.,W.M.

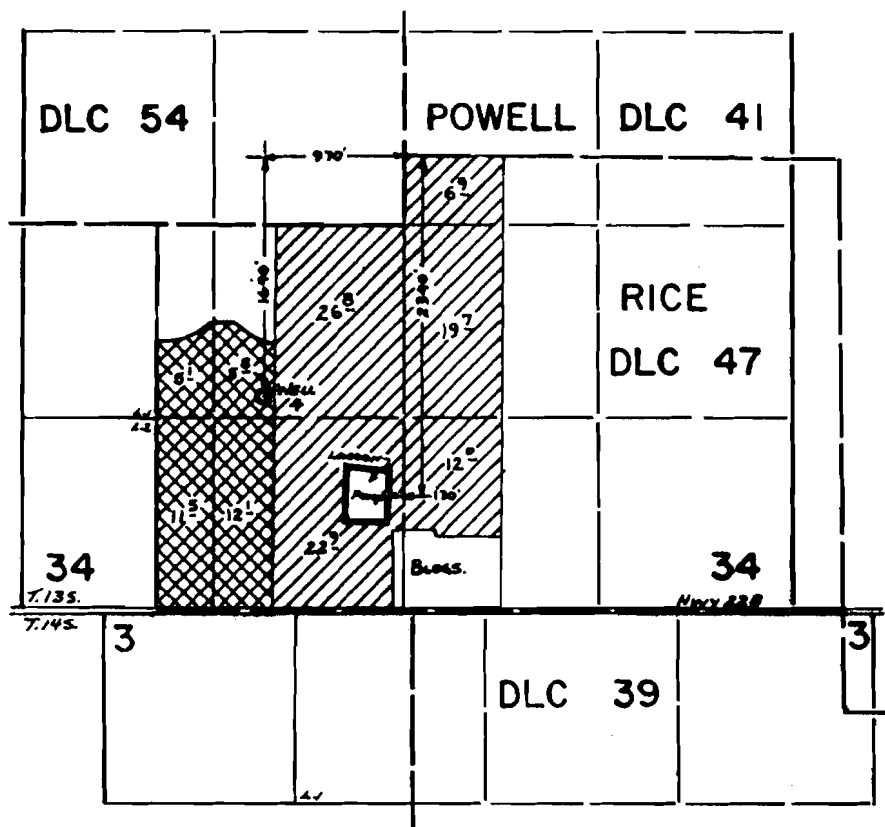

FINAL PROOF SURVEY UNDER

G-9963
R-60827
Application No. 60828... Permit No. 45197...
IN NAME OF

 PRIMARY

 SUPPLEMENTAL

NIELS PETER & HELEN E. JENSEN

Surveyed April 27... 1982, by L.M. TOLL.....