




T. 28S., R. 11W., W.M.

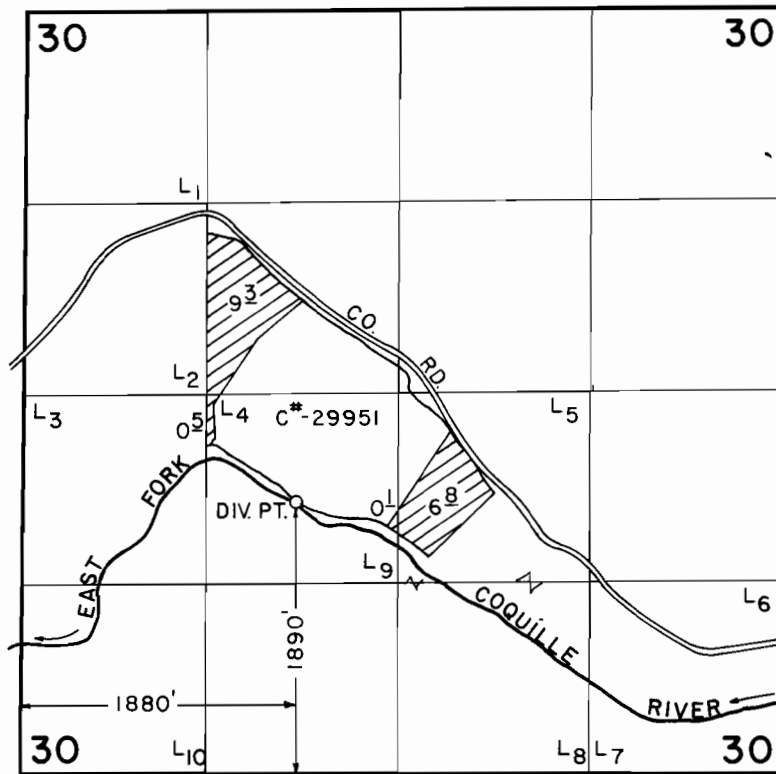

SCALE: 1" = 1320'

**FINAL PROOF SURVEY**  
UNDER

Application No. 60945 Permit No. 45418  
IN NAME OF

**BARBARA L. CARLSON**

Surveyed SEPT. 21, 1988, by B. S. JAMES